


Stafford

FORM 51 5M 6-46 PETROL

Section 8 Township 24 Range 15W **KANSAS**

Well No. 1 Askew Unit

Company J. Huber & Continental

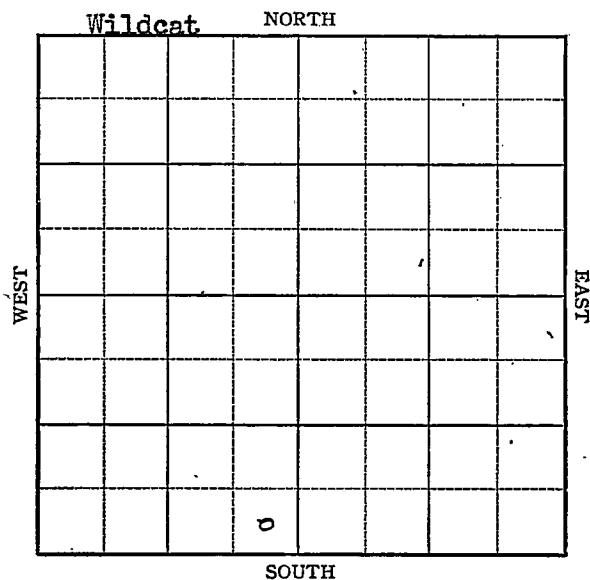

KANSAS

Stafford county

Sec. 8 Twp. 24 R. 15W

Well No. 1 Askew Unit Farm
J. Huber & Continental Company

Wildcat

 Ft. from N. Line

330


 Ft. from S. Line

330

 Ft. from E. Line

 Ft. from W. Line

SE SW

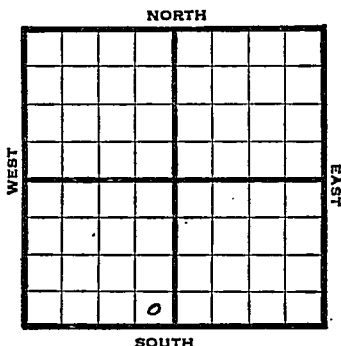

1947

2036 REPORT

5/7

Anhy 965
8" @ 970 WOC

5/13

Drlg 3030'

5/21

Arb. 4125'
TD 4145'

~~ABAND~~
ABANDONED

4145'
2036
2109


Map No. 15B3 Sec. 8 Twp. 24 R. 15WWell No. 1 Askew UnitJ. Huber & Continental Company

FIRST REPORT

Contractor

SE SW

SECTION PLAT

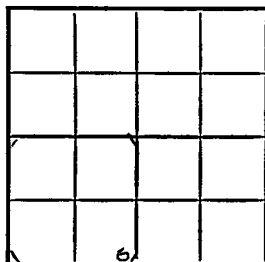 Ft. from N. Line330 Ft. from S. Line330 Ft. from E. Line Ft. from W. Line

Stafford County

Location Rig up

Drilling and Remarks:

anhy 965

8" @ 970 WOC

RECORD

Cased in., ft.Sand Gas Oil Total Depth

PRODUCTION

1st 24 hrs. Nat. 1st 24 hrs. after shot Gas Cu. Ft.Dry Hole Abandoned

Date

MAY 7 1947 19

S. J. LEWIS Scout

Map No. K 43 3 Sec. 8 Twp. 24 R. 15W

Well No. 1 Askew Unit

Huber & Continental Company

ABANDONED Contractor

SE SW


E 1.2086
SECTION PLAT

 Ft. from N. Line

330 Ft. from S. Line

330 Ft. from E. Line

 Ft. from W. Line

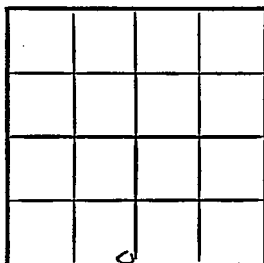

Stafford County

Location

Rig up

Drilling and Remarks:

Per 4125

RECORD

Cased in., ft.

Sand

Gas

Oil

Total Depth 4145

PRODUCTION

1st 24 hrs. Nat.

1st 24 hrs. after shot

Gas Cu. Ft.

Dry Hole

Abandoned

Date

MAY 21 1947

19

S. J. LEWIS

Scout