


Finney

KANSAS

SECTION 8 TOWNSHIP 24 RANGE 32 W

WELL NO. #1 Sloan Gas Unit

COMPANY Starolind

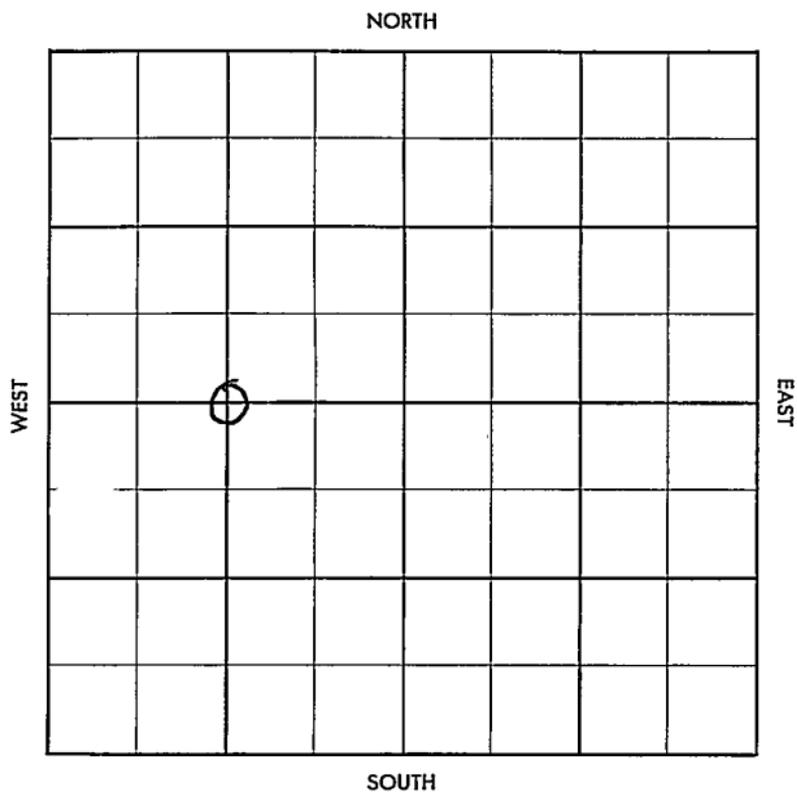

Finney

KANSAS


SEC.	TWP.	R.
8	24	32W

WELL NO. #1 Sloan Gas Unit FARM

COMPANY Stanolind

CONTRACTOR Noble Hugoton

2570' Ft. from N. Line
 _____ Ft. from S. Line
 1320' Ft. from E. Line
 _____ Ft. from W. Line

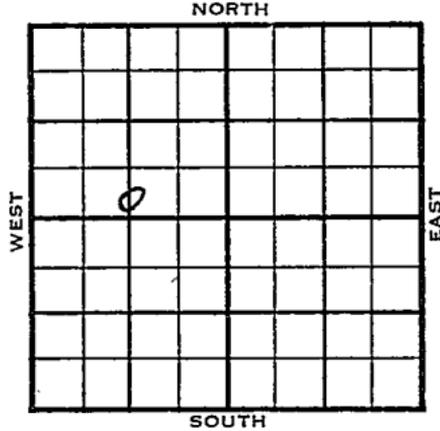

C W/2 Sec

	ELEVATION
1955	2853 DF 2856 RB ^{REBERT} 2851 GL

11/9
 12-14

Loc
 Comm. 11-9-55
 8 5/8" @ 945/500
 5 1/2" @ 2614/1000
 CO to 2611, 32/ 2590-98, 24/ 2602-08
 frac, 1,425 mcfg, 55 gwph,
 PB 2572, 8/ 2526-28, 48/ 2535-46, 16/
 2552-56, 28/ 2559-66, frac 7,546 mcfg
 CO to 2611
 Comp. 13,366 mcfgpd, 410#
 Herr. 2523
 Kri. 2551
 Winf. 2588
 TD 2616'

COMPLETED

2853 DF
2853 AD
2851 GL

County Finney Elev. 2851 Co. GL
 Sec. 8 Twp. 24 Rge. 32W
 Company Standlind
 Farm Name Sloan Gas Unit No. I

TOPS	DEPTH	LOG	DATUM
Anh.			
Tp.			
H.			
Tr.			
Dg.			
Bl.			
L.			
K.C.			
B.K.C.			
Ce.			
C.			
M.			
M.			
K.			
Mz.			
Me.			
V.			
S.			
S.			
A.			
R.			
Pe.			
G.			
T.D.			

Loc. in Sec. G W/2 Sec.
1320' EL.
2570' NL.
 Geol. _____
 Contr. Noble
 Pool Hugoton
 FIRST REPORT
 NOV 9 '55

Date Comm. _____
 Location

Co.
Lsc.
No.
Sec.
T.
R.

2853 DF
2856 RB

County Finney Elev. 2851 GF

Sec. 8 Twp. 24 Rge. 32W

Company Stanolind

Farm Name Sloan Gas Unit No. 1

TOPS	DEPTH	LOG	DATUM
Anh.			
Tp.			
H. <u>Huv.</u>	<u>2523</u>		
Tr. <u>Kri</u>	<u>2551</u>		
Dg. <u>Wing</u>	<u>2588</u>		
Bl.			
L.			
K.C.			
B.K.C.			
Ce.			
C.			
M.			
M.			
K.			
Mz.			
Me.			
V.			
S.			
S.			
A.			
R.			
Pe.			
G.			
T.D.	<u>2616</u>		

Loc. in Sec. G W¹/₂ Sec.


1320' EL

2570' NL

Geol. _____

Contr. Noble

Pool Hugoton

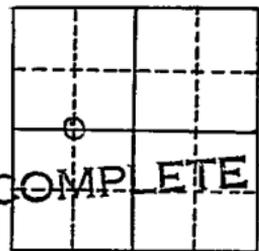

Date Comm. 11-9-55 DEC 14 1955

8 5/8" @ 945/500 5 1/2" @ 2614/1000

CO to 2611 ° 32/ 2590-98 24/ 2 602-08

frac ° 1,425 mcfg 55 gwph PB2572

8/ 2526-28 48/ 2535-46 16/ 2552-56

28/ 2559-66 frac 7,546 mcfg

CO to 2611 Comp. 13,366 mcfgpd 410#

Co.

Use.

No.

Sec.

T.

R.