


Section 8 Township 24 Range 35W

Well No. #1 Bentrop "D"

Company Stanolind

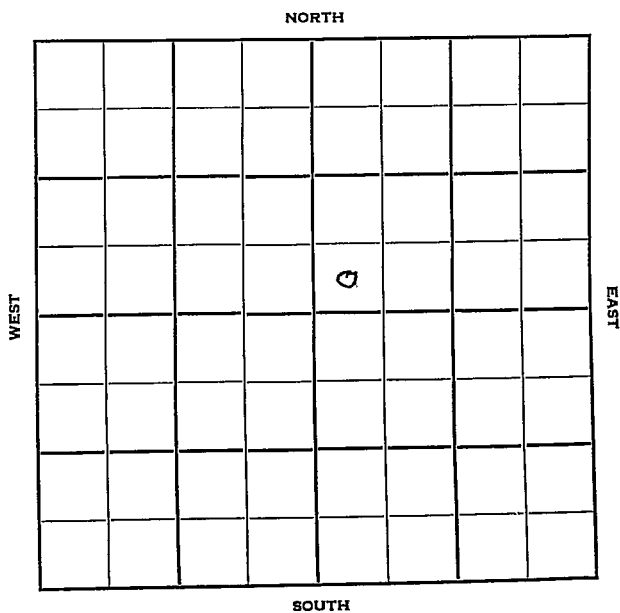

Sec. 8 Twp. 24 R. 35W

Well No. #1 Bentrop "D" Farm

Stanolind Company

Hugoton Pool Contractor

Ft. from N. Line

330


Ft. from S. Line

Ft. from E. Line

330

Ft. from W. Line

SW SW NE

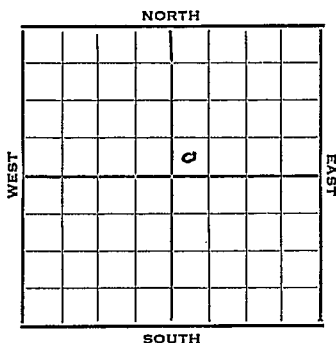

1952

Elev. 3012' REPORT

9/24

Location

10/1

8" @ 846'

Drlg. 2490'

10/8

Her. 2444

Win. 2500

Low. 2560

Ft. Riley 2614

72/ 2463-72

42/ 2483-90

12/ 2500-02

18/ 2506-09

18/ 2518-21

24/ 2528-32

48/ 2539-47

24/ 2564-68

36/ 2575-81

36/ 2584-90

24/ 2592-96

44/ 2599-2606

31500 A

10/15

"

10/22

Spud 9-22-52

Gas well TD 2647' 8" @ 846' Her

2444' Win 2500 Tow. 2560'

Ft. Riley 2614' TD 2647' 5" @ 2614'

CO to 2647 2500 A 24/2444-48

36/2453-59 72/2463-72 42/2483-90

12/2500-02 18/2506-09 18/2518-21

24/2528-32 48/2539-47 24/2564-68


36/2575-81 36/2584-90 24/2592-96

44/2599-2606 31,500 A

Comp. 14,437,000 gas 375#

COMPLETED

J. G. McGEHEE

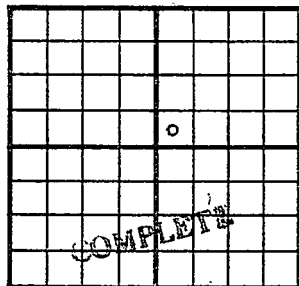County Kearny State KansasSec. 8 (Blk. Twp.) 24 (Sur. Rge.) 35W Map No.Operator StanolindWell No. 1 Farm Bentrop "D"Elev. 3012 Location SW SW NE330 Ft. From S Line NE330 Ft. From W Line Quarter1st. ReportCompletion OCT 22 1952Remarks Hugoton PoolSpudding Date 9-22-52Drig. Data Gas well TD 26478" @ 846 Her. 2444 Win. 2500Tow. 2560 Ft. Riley 2614 TD 26475" @ 2614 CO to 2647 2500 A24/ 2444-48 36/ 2453-59 72/ 2463-7242/ 2483-90 12/ 2500-02 18/ 2506-0918/ 2518-21 24/ 2528-32 48/ 2539-4724/ 2564-68 36/ 2575-81 36/ 2584-9024/ 2592-96 44/ 2599-2606 31500 AComp. 14,437,000 gas 375#