


Map No. 2-A Sec. 9 Twp. 24 R. 4W
Well No. Shell Hoskins Farm _____
_____ Company _____

NORTH

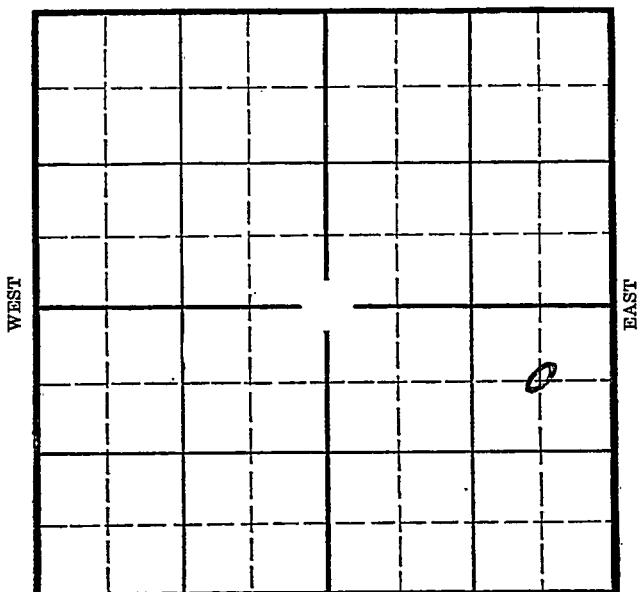

SOUTH

Location _____

Drilling Remarks

Rig Up_____

Drilling Remarks

RECORD

Cased _____ in. _____ ft.

Sand_____

Gas

Oil

Total Depth

PRODUCTION

1st 24 hrs. Nat. _____

1st 24 hrs. after shot_____

Gas_____cu. ft._____

Dry Hole_____

Abandoned_____

KANSAS

Map No. _____ Sec. 9 Twp. 24 R. 4wWell No. 2-A Hoskins Farm _____

Shell _____ Company

660 Ft. from N. Line


_____ Ft. from S. Line

660 Ft. from E. Line

_____ Ft. from W. Line

Elev. 1471

NORTH

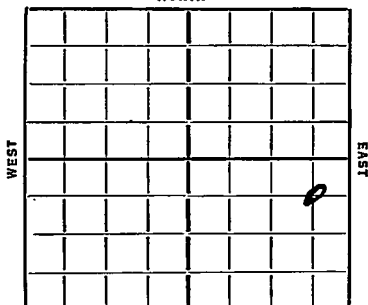

WEST

EAST

SOUTH

Date

REPORT

1935
 9/25 B.R.
 10/3 _____
 10/10 Bldg 1738 13" 507
 11/1 Top Chrt 3202
 T.D. 71 S.D.
 11/7 C.O.
 11/14 7" 3352 T.D. 3371
 flowed 663 Oil 60 wtr 24 hrs
 11/21 3374 3 m hrs 145 Bldg 8 hrs
 3380 T.D. 267 Bldg 30% wtr
 15 hrs.
 11/29 1000 acid
 flowed 200 Oil 6 hrs
 to take pot
 12/4 Chrt 3302
 T.D. 3389
 734 Oil
 120 Water

COMPLETED

Map No. 40 Sec. 9 Twp. 24 R. 4W

Well No. 2A-Hospkins

Shell Company

Contractor

REPORTS

SECTION PLAT

660 Ft. from N. Line

..... Ft. from S. Line

660 Ft. from E. Line

..... Ft. from W. Line

			0

Location.....

Rig up.....

Drilling and Remarks:

BR

RECORD

Cased.....in.,ft.

Sand.....

Gas.....

Oil.....

Total Depth.....

PRODUCTION

1st 24 hrs. Nat.....

1st 24 hrs. after shot.....

Gas.....Cu. Ft.

Dry Hole.....

Abandoned.....

Date

ORVAL MANNSCHRECK

9-25-35 192

Scout

KANSAS

Map No. 40 Sec. 9 Twp. 24 R. 4WWell No. 2A-HaskinsShell fit. Company

Contractor

SECTION PLAT

660 Ft. from N. Line

Ft. from S. Line

660 Ft. from E. Line

Ft. from W. Line

			0

RECORD

Cased _____ in. _____ ft.

Sand Chat 3302

Gas _____

Oil _____

Total Depth 3380

PRODUCTION

1st 24 hrs. Nat. _____

1st 24 hrs. after shot _____

Gas _____ Cu. Ft.

Dry Hole _____

Abandoned _____

Location _____

Rig up _____

Drilling and Remarks:

734 oil
120 water

Date

V-119 VANDERBILT

12-4-35 192 _____ Scout