


Section 9 Township 24 Range 11W

Well No. #1 Figger

Company Transwestern

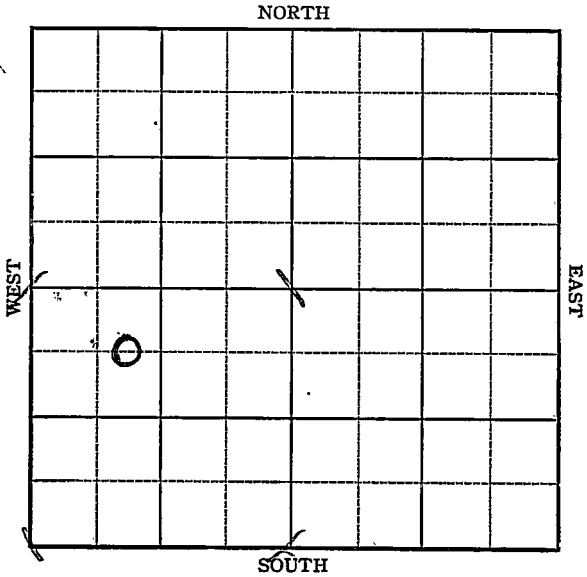

Sec. 9- Twp. 24 R. 11W

Well No. #1 Figger Farm

Transwestern Company

Zenith


660 Ft. from N. Line

_____ Ft. from S. Line

_____ Ft. from E. Line

990 Ft. from W. Line

4lev. 1827

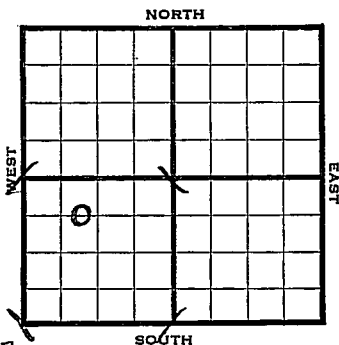

1944

REPORT

- 3/29 Location
- 4/5 Cellar
- 4/12 Rotaru
- 4/19 Rotary
- 4/26 9" @ 273
Drlg. 1200
- 5/3 Drlg. 2600'
- 5/10 3502 fsg.
- 5/17 Viola 3807-10 T.D.
5" - 3808 RUST.
- 5/24 TD 3812
Shab 33oil in 16 hrs.
- 5/31 Pump 50 oil and 3% wtr in 7 hrs.
- 6/7 " " " " " "
- 6/21 Viola 3807
5" @ 3808
T.D. 3812
Pump 132 Pot
42.0 Gr.

COMPLETED

Map No. 47 Sec. 9 Twp. 24 R. 11W

Well No. 1 Figger

Transwestern Company

FIRST REPORT Contractor

C E L NW SW

SECTION PLAT

660 Ft. from N. Line

_____ Ft. from S. Line

_____ Ft. from E. Line

990 Ft. from W. Line

Zenith Pool

Location X

Rig up _____

Drilling and Remarks:

RECORD

Cased _____ in., _____ ft.

Sand _____

Gas _____

Oil _____

Total Depth _____

PRODUCTION

1st 24 hrs. Nat. _____

1st 24 hrs. after shot _____

Gas _____ Cu. Ft.

Dry Hole _____

Abandoned _____

Date

MAR 29 1944 19

S. J. LEWIS Scout

Pool Name Zenith

Map No. 49 Sec. 9 Twp. 24 R. 11W

Well No. 1 Figger

Transwestern Company

COMPLETED Contractor

C E L NW SW

SECTION PLAT

660 Ft. from N. Line

_____ Ft. from S. Line

_____ Ft. from E. Line

990 Ft. from W. Line

Stafford County

Location _____

Rig up _____

Drilling and Remarks:

Via 3809

5" @ 3808.

Pump 132 P & Y

42 6/8

RECORD

Cased _____ in., _____ ft.

Sand _____

Gas _____

Oil _____

Total Depth 3812

PRODUCTION

1st 24 hrs. Nat. _____

1st 24 hrs. after shot _____

Gas _____ Cu. Ft.

Dry Hole _____

Abandoned _____

Date

JUN 21 1944 19

S. J. LEWIS Scout