


Section 9 Township 24 Range 11W


Well No. 1 Figger

Company Champlin Refining

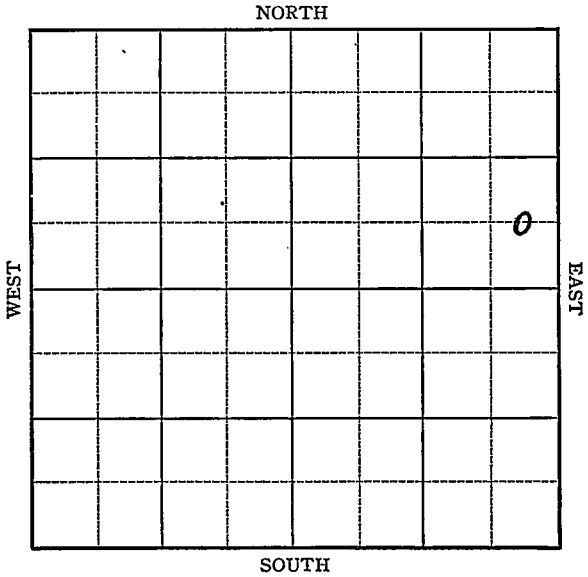

Sec. 9 Twp. 24 R. 11-WWell No. #1 Figger Farm
Champlin Refg. Company
(Zenith) Ft. from N. Line660 Ft. from S. Line330 Ft. from E. Line Ft. from W. Line

Elev. 1817

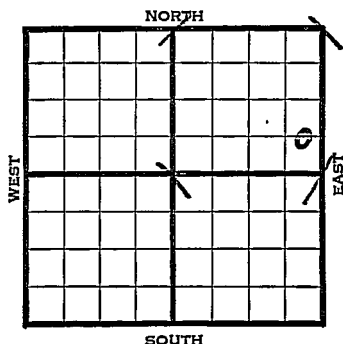

1941

REPORT

6/18

Location

6/26

Spud 40'

7/3

8" - 305' Drilg. 3009'

7/10

" " "

7/17

Viola 3783' 4" - 3783'

T.D. 3815' 3000 acid.

Flow 65 oil per hour 2 hours.

7/23

Viola 3783'

4" @ 3783'

TD 3815

3000 gas& acid

Bomb potential 6566' bbls.

Max. 3000

42.6 Gravity


COMPLETED

Map No. 47 Sec. 9 Twp. 24 R. 11WWell No. 1 FiggerChamplin Refining CompanyFIRST REPORT Contractor

C E L S E N E

 Ft. from N. Line660 Ft. from S. Line330 Ft. from E. Line Ft. from W. Line

SECTION PLAT

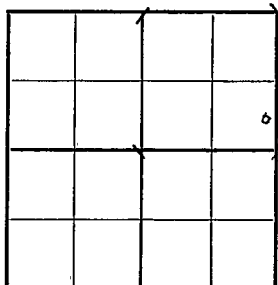

ZENITH POOL

Location XRig up Drilling and Remarks:

RECORD

Cased in., ft.Sand Gas Oil Total Depth

PRODUCTION

1st 24 hrs. Nat. 1st 24 hrs. after shot Gas Cu. Ft.Dry Hole Abandoned

Date

JUN 1 8 1941 19S. J. LEWIS Scout

Map No. 47 Sec. 9 Twp. 24 R. 11WWell No. 1 FiggerChamplin Refining CompanyCOMPLETED Contractor

C E L S E N E

SECTION PLAT

 Ft. from N. Line660 Ft. from S. Line330 Ft. from E. Line Ft. from W. Line

ZENITH POOL

			o

Location Rig up

Drilling and Remarks:

*Vista 3783**4" @ 3783**3000 accl**Born & P. 656.6**Max 3000**42 @ Gr*

RECORD

Cased in., ft.Sand Gas Oil Total Depth 3815

PRODUCTION

1st 24 hrs. Nat. 1st 24 hrs. after shot Gas Cu. Ft.Dry Hole Abandoned

Date

JUL 23 1941 19 S. J. LEWIS Scout