


Section 9 Township 24 Range 11W

Well No. #1 Figger

Company Cities Service Oil

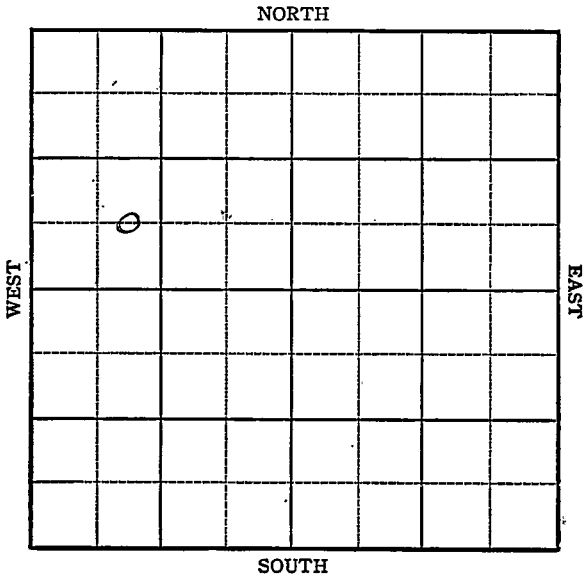


KANSAS

Stafford

Sec. 9 Twp. 24 R. 11WWell No. #1 Figger FarmCities Service Oil Company

Wildcat

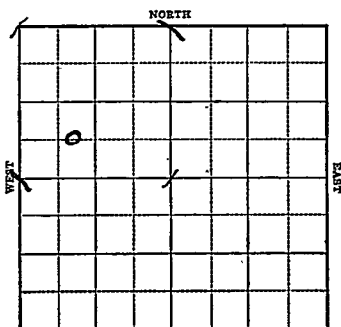 Ft. from N. Line660 Ft. from S. Line Ft. from E. Line990 Ft. from W. LineC E L SW NW Elev. 1825 SOUTH

1944

Elev. 1825 R E P O R T

2/9	Location
2/15	8" @ 254
	WOC
2/23	"
3/1	Viola 3777 V SSO
	TD 3784
	5" @ 3779
	Rust
3/8	Lans 388
	Kind 3711
	Viola 3774
	5" @ 3776
	Fishing 3000' oil in 4 hrs.
3/16	TD 3781
	Flow 280' oil in 11 hrs.
3/22	Viola 3774
	5" @ 3776
	TD 3781
	Bomb Pot. 4843
	Max. 3000
	42.0 Gravity.

COMPLETED

KANSAS
 Map No. 77 Sec. 9 Twp. 24 R. 11W
 Well No. 1 Figger

Cities Service Oil Company

FIRST REPORT

Contractor

C E L SW NW


SECTION PLAT

 Ft. from N. Line

660 Ft. from S. Line

 Ft. from E. Line

990 Ft. from W. Line

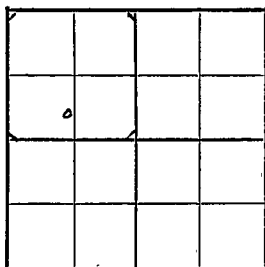

Wildcat

Location X

Rig up

Drilling and Remarks:

RECORD

Cased in., ft.

Sand

Gas

Oil

Total Depth

PRODUCTION

1st 24 hrs. Nat.

1st 24 hrs. after shot

Gas Cu. Ft.

Dry Hole

Abandoned

Date

FEB 9 1944 19

S. J. LEWIS Scout

Map No. 77 Sec. 9 Twp. 24 R. 11W

Well No. 1 Figger

Cities Service Oil

Company

COMPLETED

Contractor

C E L SW NW

SECTION PLAT

Ft. from N. Line

660

Ft. from S. Line

Ft. from E. Line

990

Ft. from W. Line

Wildcat

Location

Rig up

Drilling and Remarks:

Vid. 3774

5' 10" 3776

Born + 4543

Map 3000

420 Gr

RECORD

Cased _____ in., _____ ft.

Sand _____

Gas _____

Oil _____

Total Depth 3282

PRODUCTION

1st 24 hrs. Nat. _____

1st 24 hrs. after shot _____

Gas _____ Cu. Ft.

Dry Hole _____

Abandoned _____

Date

MAR 22 1944 19

S. J. LEWIS Scout