


Section 9 Township 24 Range 11W

Well No. #3 Figger

Company Cities Service Oil

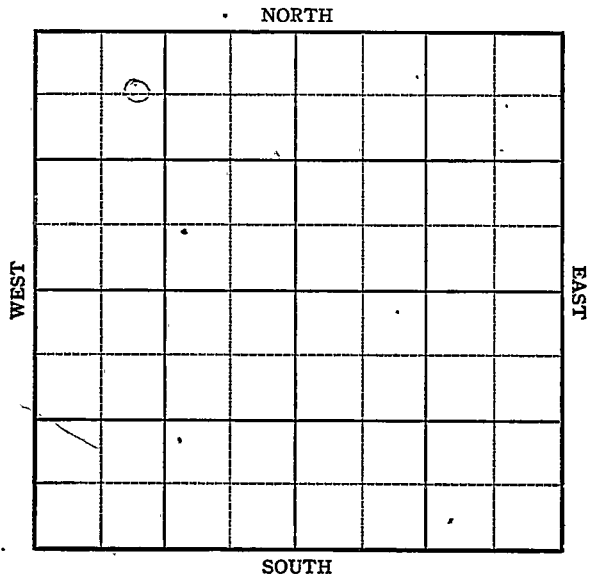

Sec. 9 Twp. 24 R. 11-W

Well No. #3 Figger Farm

Cities Service Oil Company


(Zenith)

805 Ft. from N. Line

 Ft. from S. Line

 Ft. from E. Line

990 Ft. from W. Line

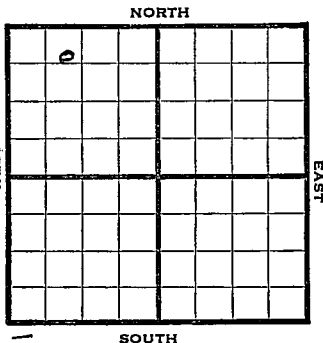

elev. 1825-

1944

REPORT

5/17	Location
5/24	Rotary
5/31	"
6/7	8" @ 252 WOC
6/15	Drlg. 2390
6/21	Drlg. 3687
6/28	Lans 3391 Viola 3763 Sat 3767 TD 5" @ 3767 RUST
7/12	500 acid Pump 65 oil in 14 hours
7/19	TD 3774 500 acid Swb 152 oil in 21 hours
7/26	TD 3774 Pump 104 oil plus 10 wtr in 14 hrs.
8/2	" " " " " " " " "
8/9	" " " " " " " " "
8/16	Viola 3763 5" @ 3764 500 Acid. Pump 91 Pot TD 3774

Gravity 42.0

COMPLETED

KANSASPool Name ZenithMap No. 47 Sec. 9 Twp. 24 R. 11WWell No. 3 FiggerCities Service Oil Company**FIRST REPORT**

Contractor

C E L NW NW

SECTION PLAT805 Ft. from N. Line

_____ Ft. from S. Line

_____ Ft. from E. Line

990 Ft. from W. Line

Stafford County

Location _____

Rig up _____

Drilling and Remarks:

RECORD

Cased _____ in., _____ ft.

Sand _____

Gas _____

Oil _____

Total Depth _____

PRODUCTION

1st 24 hrs. Nat. _____

1st 24 hrs. after shot _____

Gas _____ Cu. Ft.

Dry Hole _____

Abandoned _____

Date

MAY 17 1944 19S. J. LEWIS Scout

KANSAS Pool Name Zenith Pool

Map No. 47 Sec. 9 Twp. 24 R. 11W

Well No. 3 Figger

Cities Service Oil Company

COMPLETED Contractor

C E L NW NW

SECTION PLAT

805 Ft. from N. Line

_____ Ft. from S. Line

_____ Ft. from E. Line

990 Ft. from W. Line

o			

Stafford

Location _____

Rig up _____

Drilling and Remarks:

Viola 3763
5" @ 3764.
500 acid
Pump 910 ft

420 ft

RECORD

Cased _____ in., _____ ft.

Sand _____

Gas _____

Oil _____

Total Depth 2774

PRODUCTION

1st 24 hrs. Nat. _____

1st 24 hrs. after shot _____

Gas _____ Cu. Ft.

Dry Hole _____

Abandoned _____

Date

AUG 16 1944 19 _____

S. J. LEWIS Scout