


Section 9 Township 24 Range 11W

Well No. 4-Figger

Company Shamplin Refg.

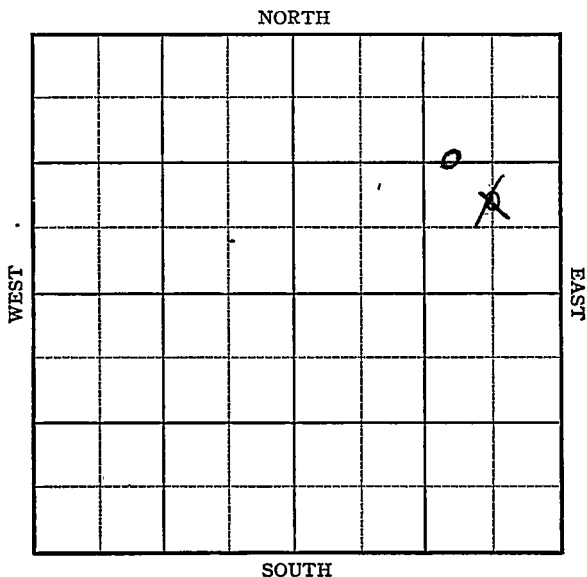

Sec. 9 Twp. 24 R. 11-W

Well No. #4 Figger Farm

Champlin Refg. Company


(Zenith)

1320 Ft. from N. Line

~~990~~ Ft. from S. Line

990
~~660~~ Ft. from E. Line

_____ Ft. from W. Line

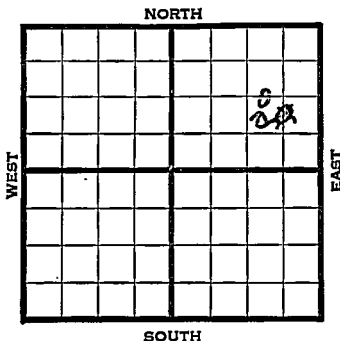

1941	REPORT
9/10	Derrick.
9/18	8" - 305' Drlg. 2625'
9/25	Viola 3767' T.D. 3781'
	Run casing.
10/2	T.D. 3789' 4" - 3768'
	3500 acid.
10/8	Viola 3767'
	4" - 3768'
	T.D. 3789'
	3500 acid.
	Bomb potential 988 bbls.
	42.6 Gravity
	COMPLETED

Map No. 47 Sec. 9 Twp. 24 R. 11WWell No. 4 FiggerChamplin Refining Company**FIRST REPORT** Contractor

SECTION PLAT

			o

C NL SE NE

_____ Ft. from N. Line

990 Ft. from S. Line660 Ft. from E. Line

_____ Ft. from W. Line

Z ENITH POOL

Location _____

Rig up _____

Drilling and Remarks:

Derrick

RECORD

Cased _____ in., _____ ft.

Sand _____

Gas _____

Oil _____

Total Depth _____

PRODUCTION

1st 24 hrs. Nat. _____

1st 24 hrs. after shot _____

Gas _____ Cu. Ft.

Dry Hole _____

Abandoned _____

Date

SEP 10 1941 19S. J. LEWIS

Scout

Map No. 47 Sec. 9 Twp. 24 R. 11W

Well No. 4 Figger

Chamlin Refining Company

Contractor

C W L E $\frac{1}{2}$ NE

1320 Ft. from N. Line

_____ Ft. from S. Line

990 Ft. from E. Line

_____ Ft. from W. Line

ZENITH POOL

SECTION PLAT

			0

Location _____

Rig up _____

Drilling and Remarks:

Reported

C NL SE NE

RECORD

Cased _____ in., _____ ft.

Sand _____

Gas _____

Oil _____

Total Depth _____

PRODUCTION

1st 24 hrs. Nat. _____

1st 24 hrs. after shot _____

Gas _____ Cu. Ft.

Dry Hole _____

Abandoned _____

Date

SEP 17 1941 19


S. J. LEWIS Scout

Map No. K-47 Sec. 9 Twp. 24 R. 11WWell No. 4 FiggerChamplin Refining Company**COMPLETED**

Contractor

C WL E $\frac{1}{2}$ NE

SECTION PLAT

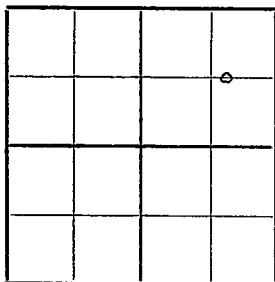1320 Ft. from N. Line Ft. from S. Line990 Ft. from E. Line Ft. from W. Line

ZENITH POOL

Location _____

Rig up _____

Drilling and Remarks:

*Vidlar 3767**4" C 3768**3500 acid**Born & P 988**42 6/8*

RECORD

Cased _____ in., _____ ft.

Sand _____

Gas _____

Oil _____

Total Depth 3789

PRODUCTION

1st 24 hrs. Nat. _____

1st 24 hrs. after shot _____

Gas _____ Cu. Ft.

Dry Hole _____

Abandoned _____

Date

NOV 8 1941 19S. J. LEWIS Scout