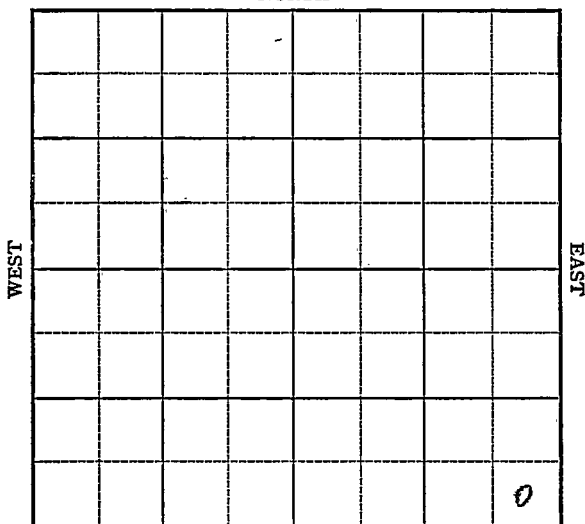


Stafford

KANSAS

Section 9 Township 24 Range 13-WWell No. #1 Jo HolmesCompany Continental, Stanolind and
Cities Service Oil

NORTH

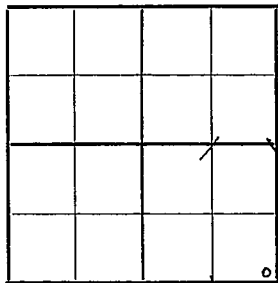


SOUTH

Map No. K-83 Sec. 9 Twp. 24 R. 13WWell No. 1 Jo HolmesContinental, Stanolind Company
and Cities Service Oil**FIRST REPORT**

Contractor

SE/C

SECTION PLAT Ft. from N. Line330 Ft. from S. Line330 Ft. from E. Line Ft. from W. Line

WILDCAT

Location XXRig up

Drilling and Remarks:

RECORDCased in., ft.Sand Gas Oil Total Depth **PRODUCTION**1st 24 hrs. Nat. 1st 24 hrs. after shot Gas Cu. Ft.Dry Hole Abandoned

Date

NOV 19 1941

19

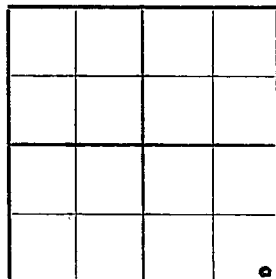
S. I. LEWIS Scout

Map No. 83 Sec. 9 Twp. 24 R. 13WWell No. 1 Jo HolmesContinental, Stanolind CompanyCities Service OilABANDONED

Contractor

SE/C

SECTION PLAT

 Ft. from N. Line330 Ft. from S. Line330 Ft. from E. Line Ft. from W. Line

WILDCAT

Location Rig up

Drilling and Remarks:

Per 84081No. 1000

RECORD

Cased in., ft.Sand Gas Oil Total Depth 4116

PRODUCTION

1st 24 hrs. Nat. 1st 24 hrs. after shot Gas Cu. Ft.Dry Hole Abandoned

Date

DEC 17 1941

19

S. J. LEWIS Scout