

9


24

14W

Section _____ Township _____ Range _____

Well No. #1 Reynolds

Company Rex & Morris & CRA

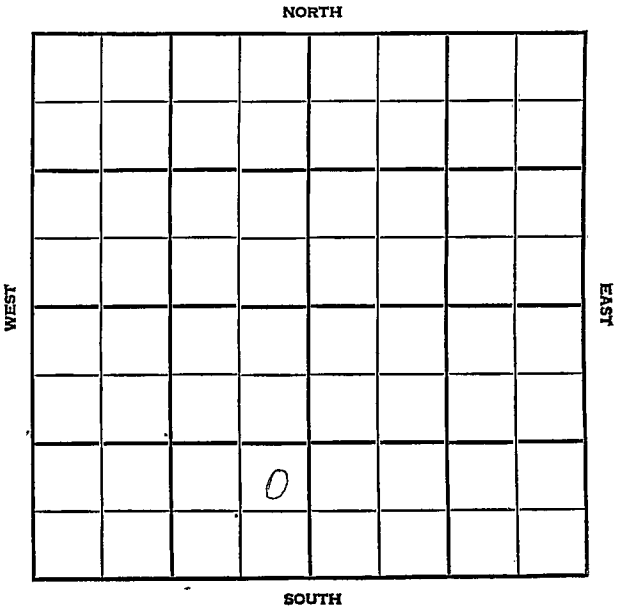

County Stafford Elev. _____
 Sec. 9 Twp. 24 Rge. 14W
 Company Rex & Morris & CRA
 FarmName Reynolds No. 1

TOPS	DEPTH	LOG	DATUM	Loc. in Sec.
Anh.				NE SE SW
TP.				
H.				
Tr.				
Dg.				
Bl.				
L.				Geol.
K.C.				Contr.
B.K.C.				<u>Rex & Morris</u>
Ce.				Pool <u>Ds/1/1/1/1</u>
C.				<u>Semi Wildcat</u>
M.				
M.				
K.				
Mz.				
Me.				
V.				
S.				
S.				
A.				
R.				
Pe.				
G.				
T.D.				

FIRST REPORT

00 31 56

SPX

Date Comm. 10-29-56 Magnolia farmout
8" @ 220/200 WOC

10-29-56

County StaffordElev. 1977Sec. 9Twp. 24Rge. 14WCompany Rex & Morris & CRAReynoldsNo. 1

	DEPTH	LOG	DATUM
Sp.	3261	3261	
H.	3514	3514	
Tr.	3535	3538	
Dg.	3551	3551	
Bl.	3656	3656	
L.	3675	3675	
K.C.			
B.K.C.		3940	
Ce.			
C.	4033	4033	
M.	4039?		
M.			
K.	4056		
Mz.			
Mo.			
V.	4100	4104	
S. sh	4213	4223	
S.			
A.	4278	4278	
R.			
Pe.			
G.			
T.D.	4310		

Loc. in Sec. NE SE SWGeol. Contr. Rex & MorrisPool DILLWIN

Semi Wildcat

ABANDONED3/8 mile

NOV 15 '56

Date Comm. 10-29-56

Magnolia farmout

8" @ 220/200

WOC NOV 7 '56

DST 3794-3815 1 hr 480' 900'+ 40" HOCH FPO BHP 160/20"MD 3960 NOV 13 '56 DST 4033-51 0.1 hr20' Md All press 0 DST 4280-850.1 hr 1800' sulphate BHP 1410/20"DGA