


Section 9 Township 24 Range 15 W

Well No. # 1 Petro

Company Petroleum Inc.

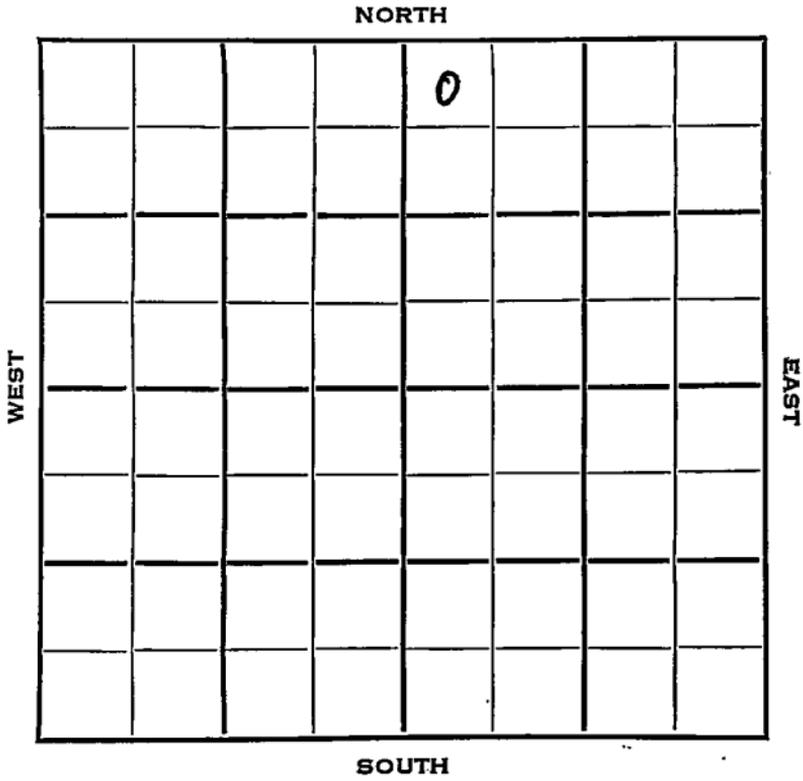

Sec. 9 Twp. 24 R. 15W

Well No. #1 Petro Farm \_\_\_\_\_

Petroleum Inc. Company \_\_\_\_\_

Petroleum Contractor \_\_\_\_\_

Wildcat.


330 Ft. from N. Line

\_\_\_\_\_ Ft. from S. Line

\_\_\_\_\_ Ft. from E. Line

330 Ft. from W. Line

NW NW NE

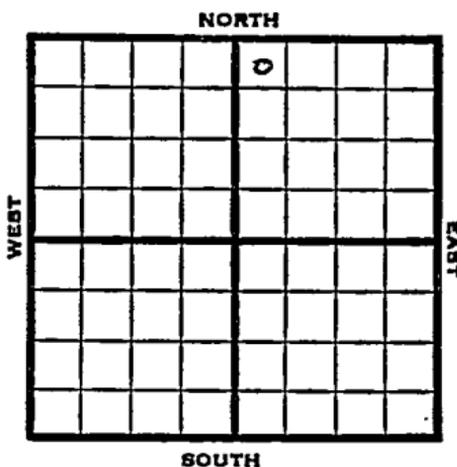

1953 Elev. 2025' REPORT

6/3 Spud 5-29-53  
8" @ 218'

Drlg 2875'

6/10 Spud 5-29-53 D & A TD 4140  
8" @ 218 Heeb 3516 Br lime 3650  
Lans 3658

DST 3777-94 open 1 hr rec 100' wtr.  
1250#

DST 3849-83 open 1 hr rec 1620' gas,  
90' HO & GCM 165# Cong 4006

Viola 4013 Simp 4069 Arb 4128

DST 4130-40 open 1 hr rec 2646' SW  
TD 4140' D & A

**ABANDONED**

County **Stafford** State **Kansas**

Sec. **9** (Blk. Twp.) **24** (Sur. Rge.) **15W** Map No.

Operator **Petroleum Inc.**

Well No. **1** Farm **Petro**

Elev. Location **NW NW NE**


**330** Ft. From **N** Line **NE**

**330** Ft. From **W** Line Quarter

Ist. Report **JUN 3 1953**

Completion

Remarks

**Petroleum & Contr.**

Spudding Date **5-29-53**

Drlg. Data **Wildcat**

**8" @ 218** d rig. **2875**

**J. G. McGEHEE**

