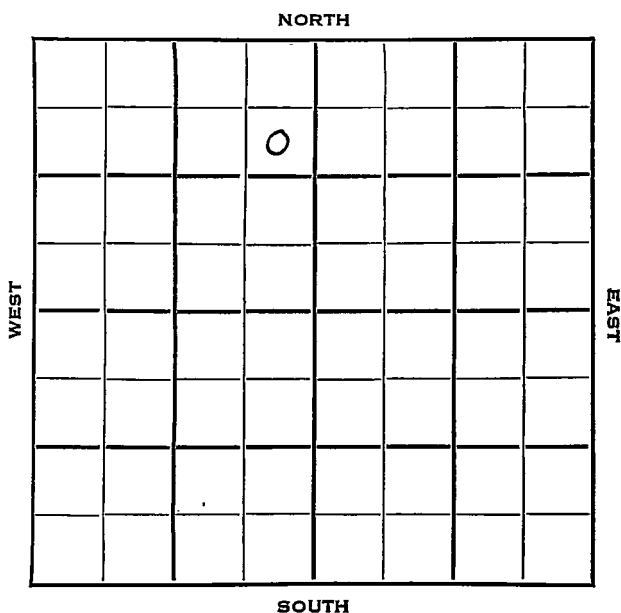


Section 9 Township 24 Range 16WWell No. #1 EnlowCompany Natural Gas & Oil et al

SEC.	9	TWP.	24	R.	16W
------	---	------	----	----	-----

WELL NO.

#1 Enlow

FARM

COMPANY

Natural Gas & Oil et al

CONTRACTOR

Natural Gas & Oil

Wildcat.


990 Ft. from N. Line

Ft. from S. Line

330 Ft. from E. Line

Ft. from W. Line

NORTH

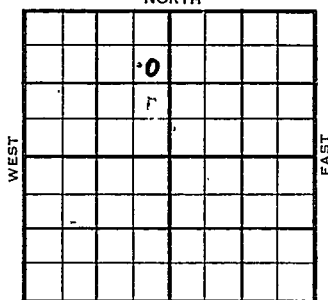

SOUTH

SE NE NW

	ELEVATION	REPORT
1953	2074'	

9/23 Spud 9-21-53

8" @ 237'

WOC.

9/30 Drlg. 3746'

10/7 N.R.

10/14 Schl Tops: Anhy 1020, Heeb 3568, Br. L. 3694, KC 3705,

DST 3711'-16' 1 hr, gas in 16", 15' M / 60' ocm- 2220' gassy oil 1420#

B KC 3904, Miss 4116'

DST 4081'-4127' 1 hr, 1,930,000 gas in 8", 900' gassy mud, 1420#

DST 4118'-60' 1 hr, gas in 6", 180'

gcm 1260# KH 4170, V. 4180, Detrida 4268, G. Wash. 4282, Granite 4284,

DST 4260'-88' 1 hr, 10' M 250#

RTD 4294'

5" @ 4293'

CO 4294 28/ 3736'-43 S/ 1 boph

1000 A S/ 5 boph 6 hrs. 4000' O.B.

10/21 WOP

OVER

1953

11/11

Spud 9-21-53 Oil well TD 4294
8" @ 237 Anhy 1020 Heeb 3568
Br lime 3694 KC 3705
DST 3711-46 open 1 hr gas in 16 min
rec 15' mud, 60' OCM, 2280' gassy
oil 1420# B KC 3904 Miss 4116
DST 4081-4127 open 1 hr, rec 1,930,000
gas in 8 min, 900' gassy mud 1420#
Kh. 4170' Viola 4180'
Detridal 4268 Gr. wash 4282'
Gr. 4284 TD 4294' 5" @ 4293
DST 4118-60 open 1 hr gas in 6 min
rec 180' GCM 1260#
DST 4260-88 open 1 hr rec 10' mud
250# CO to 4294 28/3736-43
S/1 BOPH 1000 A S/5 BOPH 6 hr.
S & F/14 BOPH F/17 BOPH
Comp. 379 BOPD

COMPLETED

County Edwards State Kansas

Sec. 9 (Blk.) 24 (Sur.) 16W Map No.

Operator **Natural Gas & Oil etal.**

Well No. 1 Farm Enlow

Elev.	Location	SE	NE	NW
-------	----------	----	----	----

0

FIRST REPORT

990 Ft. From N Line ~~TELE~~

330 Ft. From the Line Quarter

1st. Report SEP 23 1952

Completion

Remarks

Natural Gas & Oil - Contr.

Spudding Date 9-21-53

Drlg. Data Wildcat

8" @ 237 WOC

0

COMPLETE

Spudding Date 9-21-53

1000 A S/ 5 boph 6 hr. S & F/ 14 boph

J. G. McGEHEE

Drig. Data

F/ 17 boph Comp. 379 bopd

NOV 16 1963

Misc.
Place Map
Time Map
Tracings
Land Wall Map
Land Small Map
Scout Cards