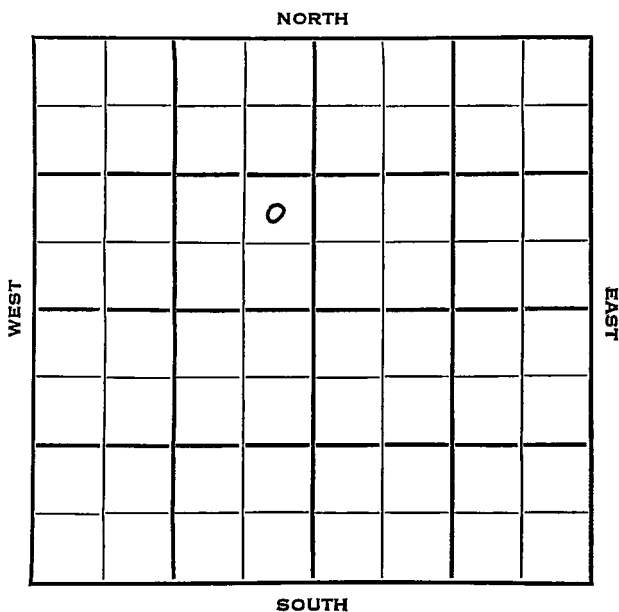


Section 9 Township 24 Range 16WWell No. 2 EnlowCompany Natural Gas & Oil

Edwards

KANSAS

SEC.

TWP.

R.

9

24

16 W

WELL NO.

2 Enlow

FARM

COMPANY

Natural Gas & Oil

CONTRACTOR

Natural Gas & Oil


_____ Ft. from N. Line

990 _____ Ft. from S. Line

330 _____ Ft. from E. Line

_____ Ft. from W. Line

NE SE NW

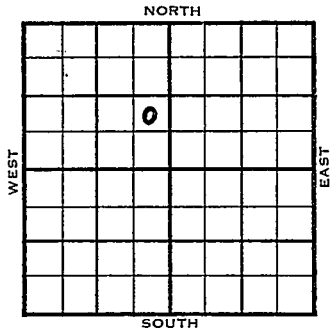

1953

ELEVATION

2074'

REPORT

11/4

Spud 11-1-53

8" @ 240

Drlg. 1215'

11/11

Anhy 1017', Br. L. 3691', Lans 3700'

DST 3701'-11' 1 hr, gas 42", 10'

HOCM / 180' frogay oil 1230#

DST 3716'-40' 1 hr, 2280' oil,

32' HOCM, 1170#

Drlg.

11/18

Drlg.

12/22

Spud 11-1-53

Oil Well

TD 4265'

8" @ 240'

Anhy 1017', Br. Lime 3691', Lans 3700'

DST 3701'-11' opn 1 hr, rec gas in 42 min, rec 10' hocm, 180' froggy oil 1230#

DST 3716'-40' opn 1 hr, rec 2280' oil 32' hocm

DST 3787'-3830' opn 1 hr, rec 625' sw 1130#

DST 3878'-3915' opn 1 hr, rec 290' sw 1290# Miss 4105'

DST 4071'-4109' opn 1 hr, rec 30' Mud 200#

OVER

1953

Information brought forward.

12/22 DST 4111'-37' opn 1 hr, rec 30' Mud
400#
Viola 4157'
DST 4143'-83' opn 1 hr, rec 35' gcm
410# PreCamb. 4252'
TD 4265'
7" @ 3846'
48/ 3728'-38' S/ $2\frac{1}{2}$ boph
200 A 500 A S & F $12\frac{1}{2}$ boph
Comp 355 bopd.

COMPLETED

County Edwards State KansasSec. 9 (Blk. Twp.) 24 (Sur. Rge.) 16W Map No.Operator Natural Gas & OilWell No. 2 Farm EnlowElev. Location NE SE NW

			0				

FIRST REPORT

990 Ft. From S Line NW330 Ft. From E Line Quarter1st. Report NOV 4 1953

Completion

Remarks


Natural Gas & Oil - Contr.Spudding Date 11-1-53

Drlg. Data

8" @ 240 drlg. 1215

J. G. McGEHEE

County Edwards State Kansas
 Sec. 9 (Bk.) 24 (Sur.) 16W Map No.
 Operator Natural Gas & Oil
 Well No. 2 Farm Enlow
 Elev. 2074 Location NE SE NW

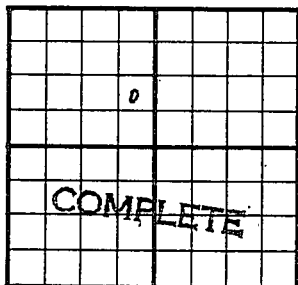

990 Ft. From S Line NW
330 Ft. From E Line Quarter

1st. Report

Completion DEC 22 1953

Remarks W

Natural Gas & Oil - Contr.

Spudding Date 11-1-53

Drilg. Data Oilwell TD 4265

8" @ 240 Anhy 1017 Br. lime 3691

Lans. 3700 DST 3701-11 open 1 hr.

gas in 42 min. Rec. 10' hocm 180' froggy

oil 1230# DST 3716-40 open 1 hr.

Rec. 2280' oil 32' hocm DST 3787-3830

open 1 hr. Rec. 625' sw 1130#

DST 3878-3915 open 1 hr. Rec. 290' sw

1290# Miss. 4105 DST 4071-4109

open 1 hr. Rec. 30' mud 200# DST 4111-

37 open 1 hr. Rec. 30' mud 400#

Viola 4157 DST 4143-83 open 1 hr.

Rec. 35' gcm 410# RreCamb. 4252

TD 4265 7" @ 3846 48/ 3728-38

S/ 2 1/2 boph 200 A 500 A S & F/ 12 1/2 boph

Comp. 355 bopd

J. G. McGEHEE