


Section 9 Township 24 Range 16W

Well No. 3 Enlow

Company Natural Gas & Oil & Okla. Explor.

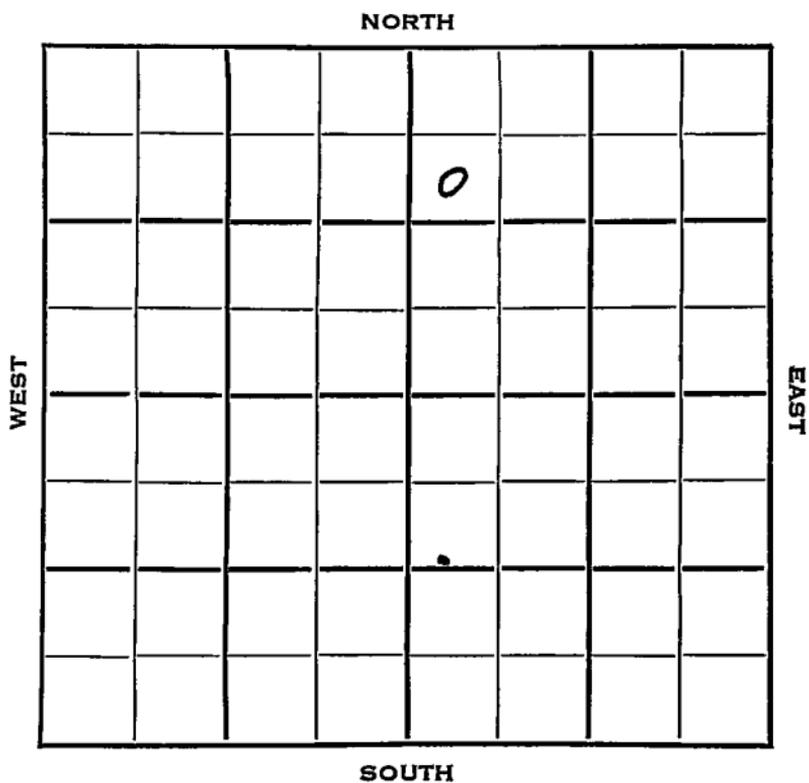

SEC.	TWP.	R.
9	24	16W ✓

WELL NO.

#3 Enlow

FARM

COMPANY

Natural Gas & Oil & Okla. Explor.

CONTRACTOR

Co. Tools.


Enlow Pool

990 Ft. from N. Line

Ft. from S. Line

Ft. from E. Line

330 Ft. from W. Line

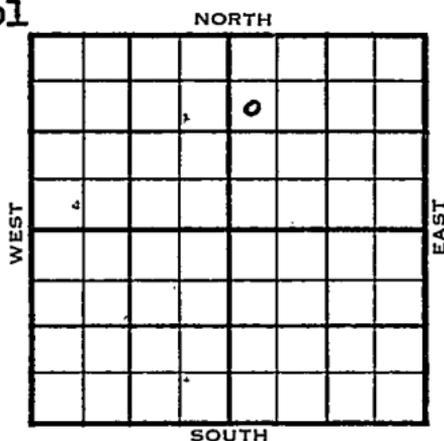

SW NW NE

	ELEVATION	REPORT
1954	2076'	
2/10	Spud 2-8-54 10" @ 196' WOC	
2/17	Anhy 1016' Drlg 2725'	
2/24	Heb 3572', Br. L. 3701', Lans 3711' DST 3705'-23' 1 hr, 25' M 110# DST 3738'-54' 1 hr, 845' oil 740# B KC 3971' Drlg 3987'	
3/3	Miss 4122', V 4184' DST 4087'-4117' 1 hr, 15' M Simp 4288' Arb 4315' DST 4284'-4320' 1 hr, 350' SW 1120' Sulph Wtr. 1440# RTD 4347' 7" @ 3816'	
3/10	CO 3774' 56/ 3740-49 S/ 1½ boph 5 hrs. 200 M-A 500 A S/ 14 boph 7 hrs. POP.	
3/24	1/2 341 bopd.	

OVER

1954
B/31

Spud 2-8-54 Oil well TD 4347
10" @ 196 Anhy 1016 Heeb 3572
Br. lime 3701 Lans. 3711
DST 3705-23 open 1 hr. rec 25' mud
110#
DST 3738-54 open 1 hr rec 845' oil
740# B KG 3971 Miss 4122 Viola 4181
DST 4087-4117 open 1 hr rec 15' mud 0#
Simp. 4288 Arb. 4315
DST 4284-4320 open 1 hr rec 350' SW
1120' sul. wtr. 1440# TD 4347
7" @ 3816 CO to 3774 56/3740-49
S/1½ BOPH 5 hr. 200 mud-acid.
500 A S/14 BOPH 7 hr.
Comp. 341 BOPD

COMPLETED

