

KANSAS

FORM 51 5M 4-41 PETROL

Edwards

Section 9 Township 24 Range 16-W

Well No. #1 Rudd

Company Herndon Drilling

Wildcat

NORTH

							0

SOUTH

WEST

EAST

Sec. 9 Twp. 24 R. 16-W

Well No. #1 Rudd Farm

Herndon Drilling Company

(Wildcat)

 Ft. from N. Line


330 Ft. from S. Line

330 Ft. from E. Line

 Ft. from W. Line

Elev. 2077

WE ARE CONTRIBUTING

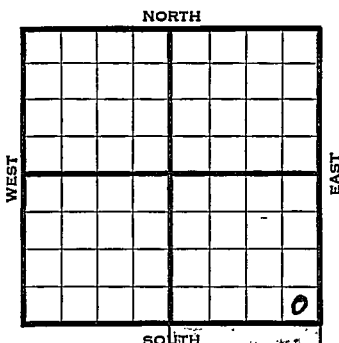

1942

REPORT

2077

6/17

R.U.R.

6/24

Spud 6-16-42. 10" - 245'

Anhy. 1065' Drlg. 2510'

6/26

Drlg. 2740' (Letter)

L 2815 139' Lower 1A 1.1.1

7/1

Lans. 3815' Drlg. 4125'

7/3

Viola 4373' & Drilling ahead.

Running very low. (Letter)

7/8

Arb. 4548'

T.D. 4583'

No shows.

ABANDONED

Map No. 84 Sec. 9 Twp. 24 R. 16WWell No. 1 RuddHerndon Drilling Company**FIRST REPORT**

Contractor

SE/C

SECTION PLAT

 Ft. from N. Line330 Ft. from S. Line330 Ft. from E. Line Ft. from W. Line

WILDCAT

Location Rig up

Drilling and Remarks:

rigging up

Rotary

RECORD

Cased in., ft.Sand Gas Oil Total Depth

PRODUCTION

1st 24 hrs. Nat. 1st 24 hrs. after shot Gas Cu. Ft.Dry Hole Abandoned

Date

JUN 17 1942

19

S. J. LEWIS

Scout

Edwards

KANSAS

Map No. 84 Sec. 9 Twp. 24 R. 16WWell No. 1 RuddHerndon Drilling

Company

ABANDONED

Contractor

SE/C

SECTION PLAT

			o

 Ft. from N. Line330 Ft. from S. Line330 Ft. from E. Line Ft. from W. Line

WILDCAT

Location Rig up

Drilling and Remarks:

*Ar 84548**No show*

i

RECORD

Cased in., ft.Sand Gas Oil Total Depth 4583

PRODUCTION

1st 24 hrs. Nat. 1st 24 hrs. after shot Gas Cu. Ft.Dry Hole Abandoned

Date

JUL 8 1942 19S. J. LEWIS Scout