


Section 9 Township 24 Range 27W

Well No. #1 A.L. Seal

Company Texas

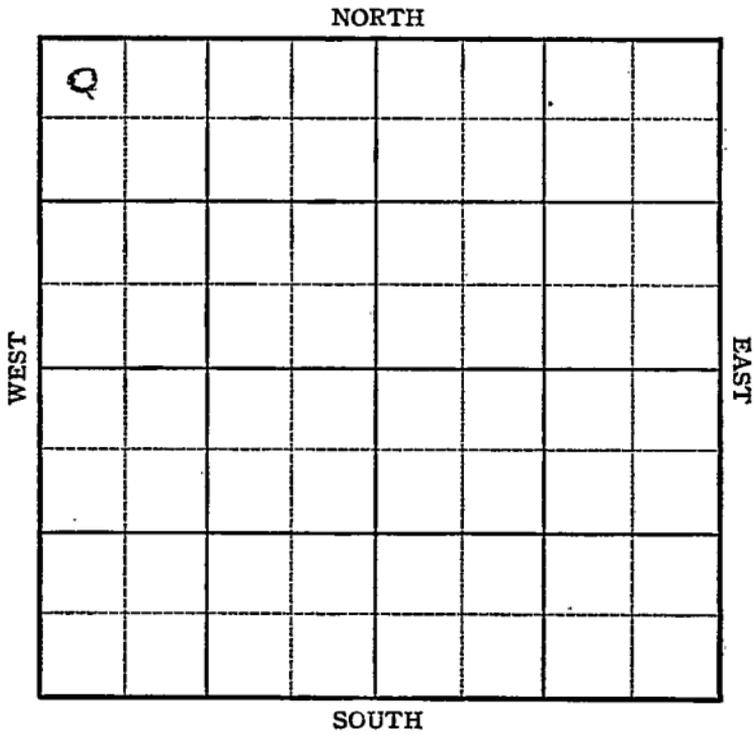

Sec. 9 Twp. 24 R. 27W

Well No. #1 A.L. Seal Farm

Texas

Company


Wildcat

330 Ft. from N. Line

\_\_\_\_\_ Ft. from S. Line

\_\_\_\_\_ Ft. from E. Line

330 Ft. from W. Line

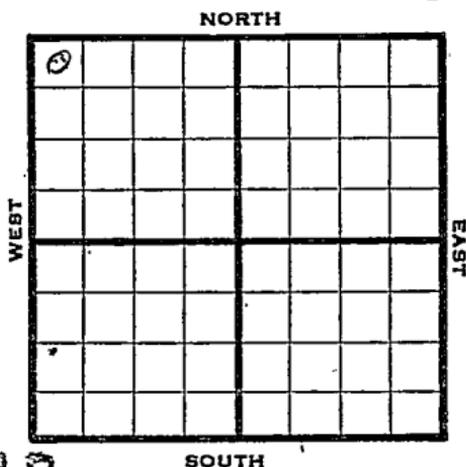

NW/c *Elmer 26 8 8*

1945

R E P O R T

3/7

R U R

3/14

13" @ 187

Drlg 1190

3/23

8" @ 2690' WOC

3/29

Blaine 1200

Anhy 1760

Hollenberg 2560

Herrington 2595

Drlg. 2792

4/5

Drlg. 3640'

4/12

8" @ 2060 corrected

Drlg. 4145

4/20

Drlg. 4660

4/27

Cong 4750

Miss 4775

Drlg. 5035-

5/9

Miss 4766

Viola 5265

Simp 5391

Arb 5402

TD 5550'

ABANDONED

Pool Name WildcatMap No. 84 Sec. 9 Twp. 24 R. 27WWell No. 1 A. L. SealTexas Company

## FIRST REPORT


NW/c Contractor

## SECTION PLAT

330 Ft. from N. Line

\_\_\_\_\_ Ft. from S. Line

\_\_\_\_\_ Ft. from E. Line

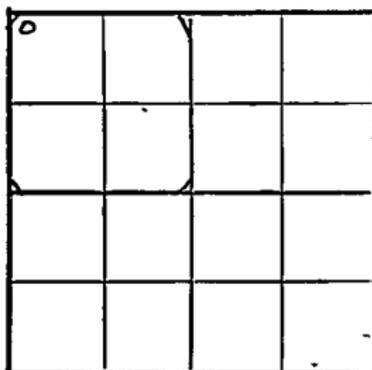330 Ft. from W. LineGray

Location \_\_\_\_\_

Rig up \_\_\_\_\_

Drilling and Remarks:

RUR

## RECORD

Cased \_\_\_\_\_ in., \_\_\_\_\_ ft.

Sand \_\_\_\_\_

Gas \_\_\_\_\_

Oil \_\_\_\_\_

Total Depth \_\_\_\_\_

## PRODUCTION

1st 24 hrs. Nat. \_\_\_\_\_

1st 24 hrs. after shot \_\_\_\_\_

Gas \_\_\_\_\_ Cu. Ft.

Dry Hole \_\_\_\_\_

Abandoned \_\_\_\_\_

Date

MAR 7 1945 19S. J. LEWIS Scout

Kansas Pool Name Wildcat

Map No. 87 Sec. 9 Twp. 24 R. 27W

Well No. 1 A. L. Seal

Texas Company

**ABANDONED**

Contractor

E 12688

**SECTION PLAT**

NW/c

330 Ft. from N. Line

\_\_\_\_\_ Ft. from S. Line

\_\_\_\_\_ Ft. from E. Line

330 Ft. from W. Line

0			

Gray County

**RECORD**

Location \_\_\_\_\_

Cased \_\_\_\_\_ in., \_\_\_\_\_ ft.

Rig up \_\_\_\_\_

Sand \_\_\_\_\_

Drilling and Remarks:

Gas \_\_\_\_\_


Oil \_\_\_\_\_

Total Depth 5550




**PRODUCTION**

1st 24 hrs. Nat. \_\_\_\_\_

1st 24 hrs. after shot \_\_\_\_\_

Gas \_\_\_\_\_ Cu. Ft.

Dry Hole \_\_\_\_\_

Abandoned \_\_\_\_\_

Date

MAY 9 1945 19

S. J. LEWIS Scout