


KANSAS Finney

FORM 51 IOM 12-46 PETROL

Section 9 Township 24 Range 33W

Well No. 1 First National Bank "B"

Company Stanlind O&G Co.

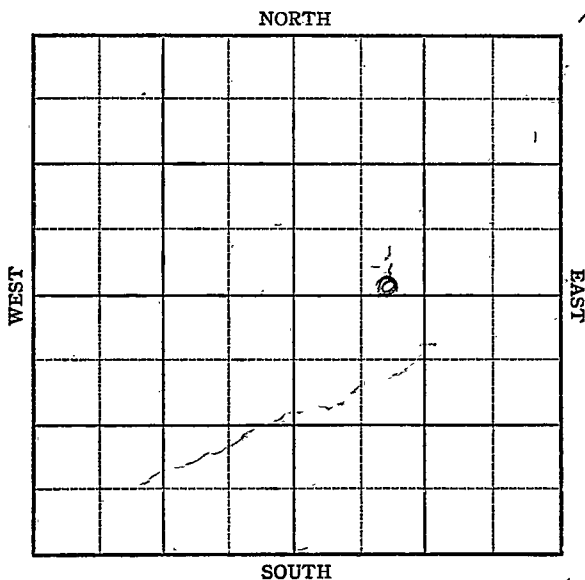

KANSAS

Finney

Sec. 9 Twp. 24 R. 33-W

Well No. #1 First National Bank "B" Farm

Stanolind

Company

Hugoton


~~2640~~ Ft. from N. Line

100 Ft. from S. Line

~~2640~~ Ft. from E. Line

990 Ft. from W. Line

~~6 Sec~~

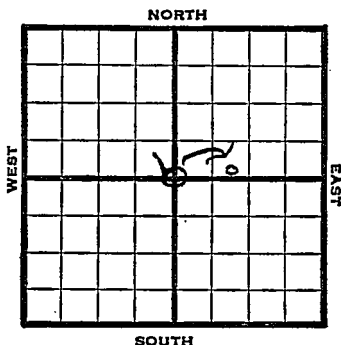

1947 Elev. 2871' REPORT

5/14 8" @ 890'
Drlg 2510'

5/20 5" @ 2644'
TD 2687'
RUST

5/27 " "

6/3 4500 acid wtr
PB 2625 WOC

6/10 " "

6/18 5" @ 2644'
Perf.
16000 Acid
2,340,000 Gas
405# R. Pr.
TD 2687'

COMPLETED

Map No. _____ Sec. 9 _____ Twp. 24 _____ R. 33W _____

Well No. 1 First National Bank "B" _____

Stanolind _____ Company

FIRST REPORT _____ Contractor

C Sec.


SECTION PLAT

2640 _____ Ft. from N. Line

_____ Ft. from S. Line

2640 _____ Ft. from E. Line

_____ Ft. from W. Line

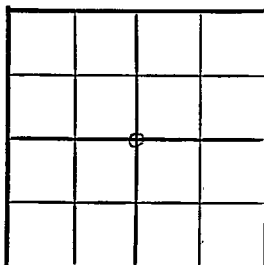

Finney County

Location _____

Rig up _____

Drilling and Remarks:

8" @ 890'

2510'

RECORD

Cased _____ in., _____ ft.

Sand _____

Gas _____

Oil _____

Total Depth _____

PRODUCTION

1st 24 hrs. Nat. _____

1st 24 hrs. after shot _____

Gas _____ Cu. Ft.

Dry Hole _____

Abandoned _____

Date

MAY 14 1947

19

S. J. LEWIS

Scout

Map No. _____ Sec. 9 Twp. 24 R. 33W

Well No. 1 First National Bank "B"

Stanolind

Company

CORRECTION

Contractor

SE SW NE

SECTION PLAT

_____ Ft. from N. Line

100 Ft. from S. Line

_____ Ft. from E. Line

990 Ft. from W. Line

Finney County

Location _____

Rig up _____

Drilling and Remarks:

Reported

C Sec.

RECORD

Cased _____ in., _____ ft.

Sand _____

Gas _____

Oil _____

Total Depth _____

PRODUCTION

1st 24 hrs. Nat. _____

1st 24 hrs. after shot _____

Gas _____ Cu. Ft.

Dry Hole _____

Abandoned _____

Date

MAY 28 1947

19

S. J. LEWIS

Scout

Map No. 0 Sec. 9 Twp. 24 R. 33W

Well No. 1 First Nat'l Bank "B"

Stanolind Company

COMPLETE

Contractor

SE SW NE

E-2871
SECTION PLAT

		0	

 Ft. from N. Line

100 Ft. from S. Line

 Ft. from E. Line

990 Ft. from W. Line

Finney County

Location

Rig up

Drilling and Remarks:

5' @ 2644

Ref.

16000 acial

2,840,000 Gas

40.5 # R/R

RECORD

Cased in., ft.

Sand

Gas

Oil

Total Depth 2687

PRODUCTION

1st 24 hrs. Nat.

1st 24 hrs. after shot

Gas Cu. Ft.

Dry Hole

Abandoned

Date

JUN 1 8 1947 19

S. J. LEWIS

Scout