


Map No. KANSAS Sec. 36 Twp. 25 R. 12

Well No. 1-1-1 Farm \_\_\_\_\_  
Prairie Oil Company

NORTH

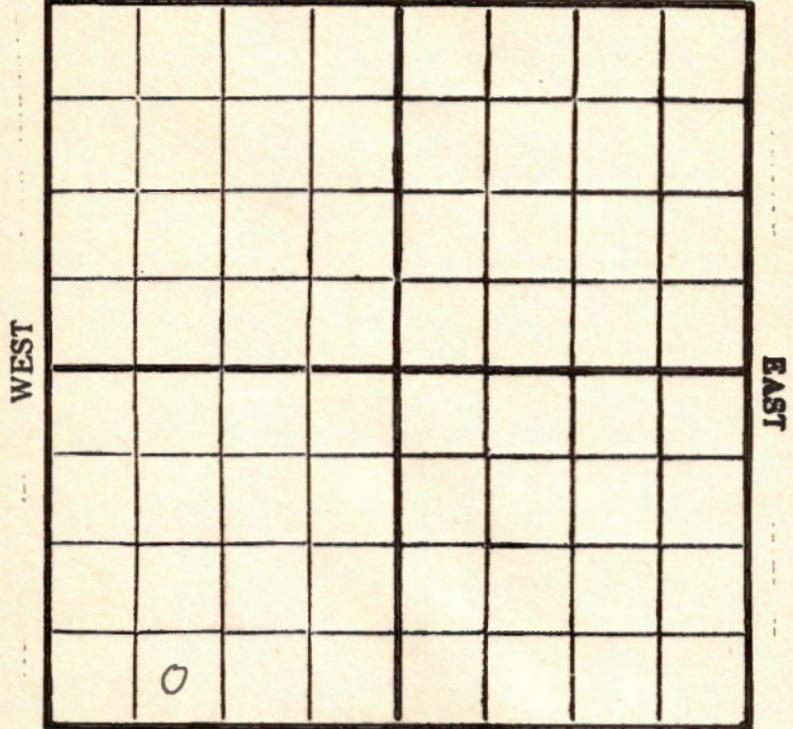

SOUTH

Location \_\_\_\_\_  
Drilling Remarks \_\_\_\_\_

Rig Up \_\_\_\_\_  
Drilling Remarks \_\_\_\_\_

\_\_\_\_\_

\_\_\_\_\_

RECORD

PRODUCTION

Cased \_\_\_\_\_ in. \_\_\_\_\_ ft.

Sand \_\_\_\_\_

Gas \_\_\_\_\_

Oil \_\_\_\_\_

Total Depth \_\_\_\_\_

1st 24 hrs. Nat. \_\_\_\_\_

1st 24 hrs. after shot \_\_\_\_\_

Gas \_\_\_\_\_ cu. ft. \_\_\_\_\_


Dry Hole \_\_\_\_\_

Abandoned \_\_\_\_\_

Map No. **KANSAS** Sec. **36** Twp. **25** R **1<sup>W</sup>**

Well No. **1 - Symon** Farm  
**Prairie O & G** Company

NORTH

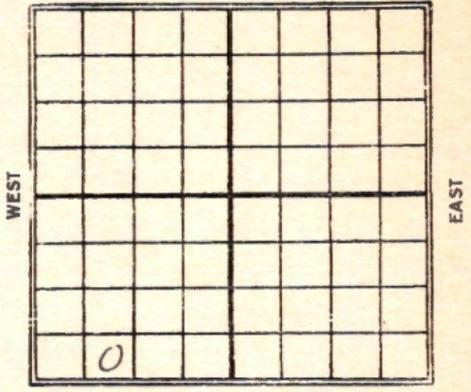

..... Ft. from N. Line

**330** Ft. from S. Line

..... Ft. from E. Line

**990** Ft. from W. Line

SOUTH

**1924**

Date	REPORT
10/30	Bldy Rq
11/16	Rgn up
11/13	shd 100'
11/20	Dry 460
11/27	1347
12/4	W.R. 6" - 3565
12/11	Dry 2290
12/18	" 2525'
12/23	" 2650'
12/30	" 2840'
1930	
1/8	VIR 8" - 3060'
1/15	Dry 3125'
1/22	sand 3366-67 sho oil
	Dry 3367'
1/29	sand 3466-70'
	T.D. 3470' HFW
	Dry & Abandon

*Scout*

Map No. **KANSAS** Sec. *36* Twp. *25* R. *1W*

Well No. *184 user*

*Prairie Oil Co* Company

Contractor

SECTION PLAT

..... Ft. from N. Line

*330* Ft. from S. Line

..... Ft. from E. Line

*990* Ft. from W. Line

<i>0</i>			

FIRST REPORTS

Location.....

Rig up.....

Drilling and Remarks:

*Build rig*

RECORD

Cased..... in., ..... ft.

Sand.....

Gas.....

Oil.....

Total Depth.....

PRODUCTION

1st 24 hrs. Nat.....

1st 24 hrs. after shot.....

Gas..... Cu. Ft.

Dry Hole.....

Abandoned.....

Date

**OCT 30 1929**

192

**S. J. LEWIS**

Scout

Map No. **KANSAS** Sec. 26 Twp. 25 R. 1W

Well No. 1 Symsen

Prairie Oil & Gas Company

Contractor

SECTION PLAT

..... Ft. from N. Line

330 Ft. from S. Line

..... Ft. from E. Line

990 Ft. from W. Line


ABANDONED

Location.....

Rig up.....

Drilling and Remarks:

XPW

RECORD

Cased..... in., ..... ft.

Sand 3466-70

Gas.....

Oil.....

Total Depth 3470

PRODUCTION

1st 24 hrs. Nat.....

1st 24 hrs. after shot.....

Gas..... Cu. Ft.

Dry Hole.....

Abandoned.....

Date

**JAN 29 1930**

192.....

**S. J. LEWIS**

Scout