

Sedgwick

Map No. **KANSAS** Sec. *36* Twp. *25* R. *1^w*

Well No. *2-Summer* Farm

~~Cladonia Oil~~ Company


Prairie O & A

..... Ft. from N. Line

330 Ft. from S. Line

..... Ft. from E. Line

990 Ft. from W. Line

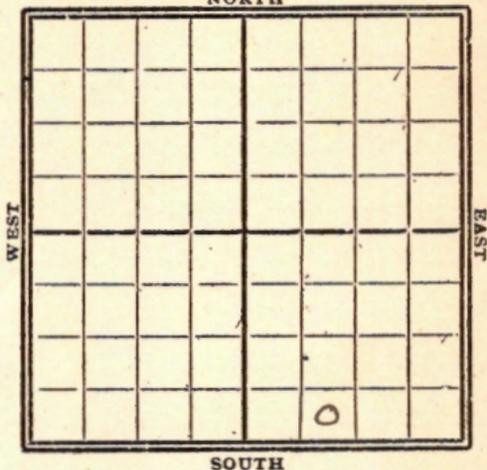

1929

Date REPORT

<i>1/2</i>	<i>Location</i>
<i>1/9</i>	<i>Bldg Rig</i>
<i>1/16</i>	<i>Rig</i>
<i>1/23</i>	<i>Rigs up</i>
<i>1/30</i>	
<i>2/6</i>	<i>drlg 775'</i>
<i>2/13</i>	<i>" 1350'</i>
<i>2/20</i>	<i>" 1770'</i>
<i>2/27</i>	<i>" 2420'</i>
<i>3/6</i>	<i>" 2708'</i>
<i>3/13</i>	<i>Top chat 3048-50'</i>
<i>3/20</i>	<i>drlg 3170'</i>
<i>3/27</i>	<i>run 5"-3391'-TD.</i> <i>had show oil</i>
<i>4/3</i>	<i>Simp. sand 3391-3400</i> <i>TD. 3400'</i> <i>Swabbing 158 bbl oil</i> <i>Pump.</i>

Map No. Bedgwick KANSAS Sec. 26 Twp. 25 R. 1W

Well No. No. 1049 Symser

Aladdin Oil Company

Contractor

SECTION PLAT

Ft. from N. Line

280 Ft. from S. Line

Ft. from E. Line

990 Ft. from W. Line

FIRST REPORTS

Location

Rig up

Drilling and Remarks:

RECORD

Cased.....in.,ft.

Sand.....

Gas.....

Oil.....

Total Depth.....

PRODUCTION

1st 24 hrs. Nat.....

1st 24 hrs. after shot.....

Gas.....Cu. Ft.

Dry Hole.....

Abandoned.....

Date
JAN 2 - 1929

S. J. LEWIS

192.....

Scout

Map No. **KANSAS** Sec. 26 Twp. 25 R. 1W

Well No. 2 Symsee

Prairie O & Gas Company

Contractor

SECTION PLAT

..... Ft. from N. Line

330 Ft. from S. Line

..... Ft. from E. Line

990 Ft. from W. Line

CORRECTION

Location.....

Rig up.....

Drilling and Remarks:

P. O & G. Co. has taken this over from the Caladden Oil Co.

RECORD

Cased..... in., ft.

Sand.....

Gas.....

Oil.....

Total Depth.....

PRODUCTION

1st 24 hrs. Nat.....

1st 24 hrs. after shot.....

Gas..... Cu. Ft.

Dry Hole.....

Abandoned.....

Date

APR 3 1920

S. J. LEWIS

Scout

Map No. **KANSAS** Sec. 36 Twp. 25 R. 1W
Well No. 2 Sumner

Prairie Oil & Gas Company
Contractor

SECTION PLAT

.....Ft. from N. Line
330 Ft. from S. Line
.....Ft. from E. Line
990 Ft. from W. Line

COMPLETED

Location.....

Rig up.....

Drilling and Remarks:

Simpson Sand
3391 to 3400
Swabbing 158 ft

RECORD

Cased.....in.,ft.
Sand.....
Gas.....
Oil.....
Total Depth.....3400

PRODUCTION

1st 24 hrs. Nat.....
1st 24 hrs. after shot.....
Gas.....Cu. Ft.
Dry Hole.....
Abandoned.....

Date

APR 3 1929

S. J. LEWIS

Scout