

Map No. **KANSAS** Sec. 36 Twp. 25 R. 1 W

Well No. 1- Valley Center Farm

Richard & Hannan Company

Valley Center NORTH 1<sup>st</sup> S. BIK 14

						0	

WEST

EAST

SOUTH

Location.....

Drilling Remarks

Rig Up.....

Drilling Remarks

.....

.....

RECORD

PRODUCTION

Cased..... in..... ft.

Sand.....

Gas.....

Oil.....

Total Depth.....

1st 24 hrs. Nat.....

1st 24 hrs. after shot.....

Gas..... cu. ft.....

Dry Hole.....

Abandoned.....

Map No. **KANSAS** Sec. 36 Twp. 25 R. 1<sup>w</sup>

Well No. 1- Valley Center Farm

Richard & Haun Company


Valley Center T5te.

5. Blk 14  
590 Ft. from N. Line

\_\_\_\_\_ Ft. from S. Line

\_\_\_\_\_ Ft. from E. Line

1675 Ft. from W. Line

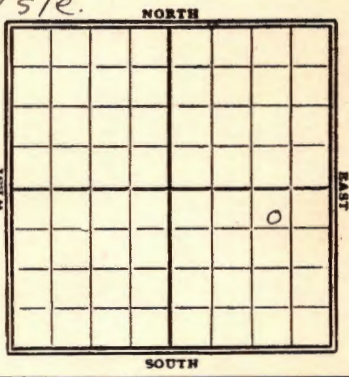

1929

Date	REPORT
2/1	Rig
2/6	Spud
2/13	drlg 425'
2/20	" 1350'
2/27	" 1610'
3/6	" 2030'
3/13	" 2550'
3/20	S.D. 2550'
3/27	drlg 2690'
4/3	" 2730'
4/10	" 2800'
4/17	" 3035'
4/24	" 3053'
5/1	gap chat 3060 T.D. 3140 - W.R. 6"
5/8	_____
5/15	drlg 3300'
5/22	Base. miss lime 3347 drlg 3350'
5/29	Simpson 3419-24 swabbed 50. hbls 15-hrs - some water
6/5	Run tubing to pump

6/12 - pumping 15 bbls oil

6/19 - Simpson 3419-24

T.D. 3424

Dry & Abandoned

*Sedgwick*

MAP NO. **KANSAS** SEC. *36* TWP. *25* R. *1X*

WELL NO. *Valley Center*

*Richard H. Hann* COMPANY

*Valley Center Transits* CONTRACTOR

*South Block 14 Reserve A.*

**SECTION PLAT**

			0

*590* FT. FROM N. LINE

\_\_\_\_\_ FT. FROM S. LINE

\_\_\_\_\_ FT. FROM E. LINE

*1675* FT. FROM W. LINE

**FIRST REPORTS**

LOCATION \_\_\_\_\_

RIG UP \_\_\_\_\_

DRILLING AND REMARKS:

*Rig Measurements from section line*

**RECORD**

CASED \_\_\_\_\_ IN. \_\_\_\_\_ FT.

SAND \_\_\_\_\_

GAS \_\_\_\_\_

OIL \_\_\_\_\_

TOTAL DEPTH \_\_\_\_\_

**PRODUCTION**

1ST 24 HRS. NAT. \_\_\_\_\_

1ST 24 HRS. AFTER SHOT \_\_\_\_\_

GAS \_\_\_\_\_ CU. FT.

DRY HOLE \_\_\_\_\_

ABANDONED \_\_\_\_\_

DATE

**JAN 30 1929**

192

**S. J. LEWIS**

SCOUT

Map No. **KANSAS** Sec. 36 Twp. 25 R. 1W

Well No. 1 Valley Center

Richard D. Hanson Company

Valley Center Contractor

Register A.

**SECTION PLAT**

590 Ft. from N. Line

..... Ft. from S. Line

..... Ft. from E. Line

1675 Ft. from W. Line

			0

**ABANDONED**

Location.....

Rig up.....

Drilling and Remarks:

Simpson sand  
3419-24

J. H.

**RECORD**

Cased..... in., ..... ft.

Sand.....

Gas.....

Oil.....

Total Depth 3424

**PRODUCTION**

1st 24 hrs. Nat.....

1st 24 hrs. after shot.....

Gas..... Cu. Ft.

Dry Hole.....

Abandoned.....

Date

**JUN 19 1929**

**S. J. LEWIS** Scout