


Sedgwick
 Map No. **KANSAS** Sec. *36* Twp. *25* R. *1W*
 Well No. *17* *Stittaker* Farm
Robinson et al Company
Valley Center NORTH *Lot 114 Blk 23*

WEST

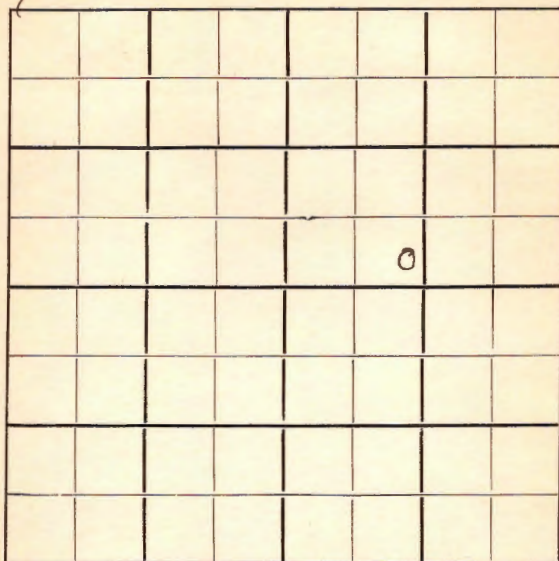

EAST

SOUTH

Location.....

Drilling Remarks

.....

.....

.....

.....

.....

.....

.....

.....

.....

.....

RECORD

Cased..... in..... ft.

Sand.....

Gas.....

Oil.....

Total Depth.....

Rig Up.....

Drilling Remarks

.....

.....

.....

.....

.....

.....

.....

.....

.....

.....

PRODUCTION

1st 24 hrs. Nat.....

1st 24 hrs. after shot.....

Gas..... cu. ft.....

Dry Hole.....

Abandoned.....

Sedgwick
FORM 252A-5M-12-28-PETROL

Map No. **KANSAS** Sec. 36 Twp. 25 R. 1^W

Well No. 1- Hittaker Farm

Robinson et al Company

Valley Center
Lot 14 - Bk 23


Ft. from N. Line

225 Ft. from S. Line

Ft. from E. Line

1240 Ft. from W. Line

1929

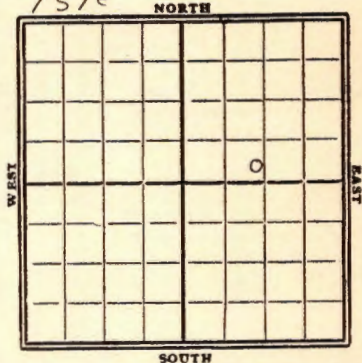

Date _____

REPORT

2/6	Rign up.
2/6	Spud 210'
2/13	drlg 820'
2/19	" 1400'
2/26	" 2000'
3/6	" 2385'
3/13	" 2600'
3/20	" 2760'
3/27	Top chat 3075'
	drlg 3150'
4/3	" 3245'
4/10	" 3300'
4/17	Veolay lime 3438-60
	had H.F.W.
	shale 3460-66
	T.D. 3466'
	Dry & Abandoned

MAP NO. **KANSAS** SEC. 36 TWP. 25 R. 1W

WELL NO. Whittaker

Robinson & Dal COMPANY

Vallay Center Township CONTRACTOR

Lot 1/4 NW 1/4 Sec 36 T25 R1W SECTION PLAT
Block 23

 FT. FROM N. LINE

225 FT. FROM S. LINE

 FT. FROM E. LINE

1240 FT. FROM W. LINE

FIRST REPORTS

LOCATION

RIG UP

DRILLING AND REMARKS:

*Rigging up
Measurements
from section line*

RECORD

CASED IN. FT.

SAND

GAS

OIL

TOTAL DEPTH

PRODUCTION

1ST 24 HRS. NAT.

1ST 24 HRS. AFTER SHOT

GAS CU. FT.

DRY HOLE

ABANDONED

DATE

JAN 30 1929

S. J. LEWIS

SCOUT


SECTION PLAT

.....Ft. from N. Line

225 Ft. from S. Line

.....Ft. from E. Line

1240 Ft. from W. Line

		6	

ABANDONED

Location.....

Rig up.....

Drilling and Remarks:

Via line 34383460 1/4 NWShale 3460-661/4 NW

RECORD

Cased.....in.,ft.

Sand.....

Gas.....

Oil.....

Total Depth 3466

PRODUCTION

1st 24 hrs. Nat.....

1st 24 hrs. after shot.....

Gas.....Cu. Ft.

Dry Hole.....

Abandoned.....

Date

APR 17 1929

192.....

S. J. LEWIS

Scout