


Section 26 Township 25 Range 1W

Well No. #1 Underwood

Company Shawyer & Graham

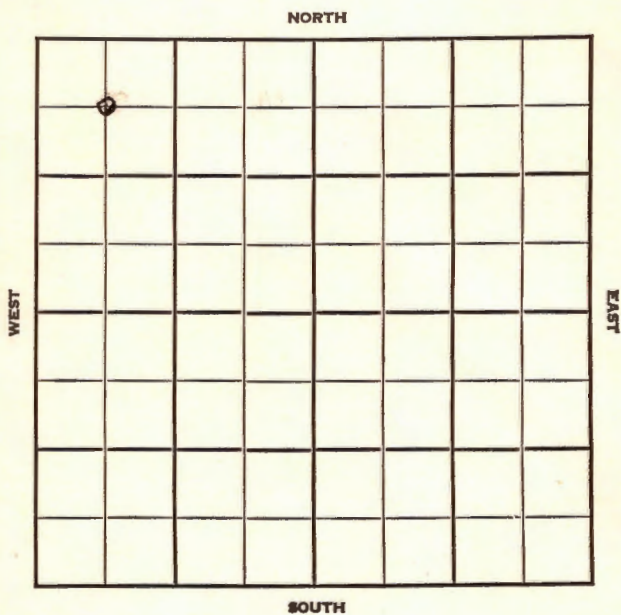



Sec. 26 Twp. 25 R. 1W

Well No. #1 Underwood Farm

Shawver & Graham Company
Misc.


660 Ft. from N. Line

_____ Ft. from S. Line

_____ Ft. from E. Line

660 Ft. from W. Line

C NW NW

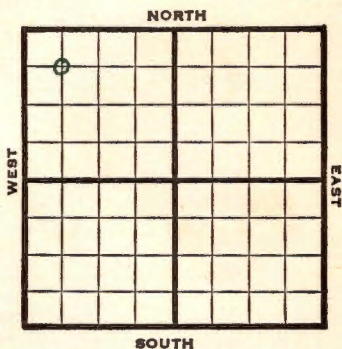

1948

REPORT

1/14

Lans. 2677'
 5" @ 2678'
 TD 2727'
 2000 acid
 25 oil & 50 water Cpt.
 40.0 gr.

FIRST REPORT
 +
 COMPLETED

Map No. 39 Sec. 26 Twp. 25 R. 1W

Well No. 1 Underwood

Shawver & Graham Company

FIRST REPORT Contractor

C NW NW

COMPLETE SECTION PLAT

660 Ft. from N. Line

_____ Ft. from S. Line

_____ Ft. from E. Line

660 Ft. from W. Line

o			

Sedgwick County

Location _____

Rig up _____

Drilling and Remarks:

Lans. 2677
5" @ 2678
TD 2727
2000 acid
25 oil & 50 water
cpt

RECORD

Cased _____ in., _____ ft.

Sand _____

Gas _____

Oil

Total Depth 2727

PRODUCTION

1st 24 hrs. Nat. _____

1st 24 hrs. after shot _____

Gas _____ Cu. Ft.

Dry Hole _____

Abandoned _____

Date

JAN 14 1948

19

S. J. LEWIS

Scout