


Sedgewick

Form 51-5M-5-34-Palace

Map No. **KANSAS** Sec. *26* Twp. *25* R. *1W*

Well No. *1 Underwood* Farm
Ed Spencer Company

NORTH

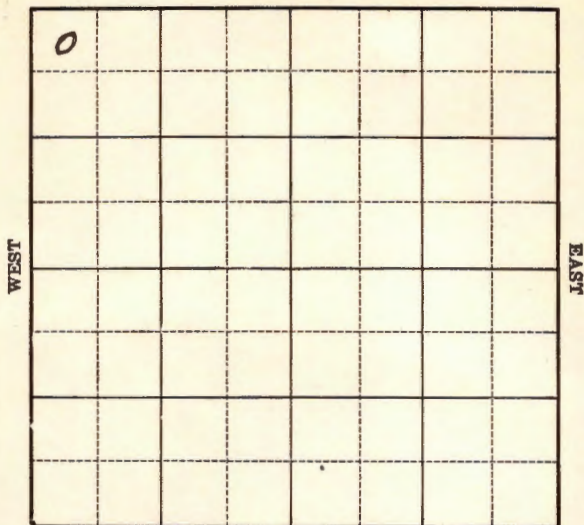

SOUTH

Location _____

Drilling Remarks _____

Rig Up _____

Drilling Remarks _____

RECORD

Cased _____ in. _____ ft.

Sand _____

Gas _____

Oil _____

Total Depth _____

PRODUCTION

1st 24 hrs. Nat. _____

1st 24 hrs. after shot _____

Gas _____ cu. ft. _____

Dry Hole _____

Abandoned _____

Adgwick

Map No. **KANSAS** Sec. 26 Twp. 25 R. 1st

Well No. 1 Underwood Farm


Jed Spencer Company

330 Ft. from N. Line

_____ Ft. from S. Line

_____ Ft. from E. Line

330 Ft. from W. Line

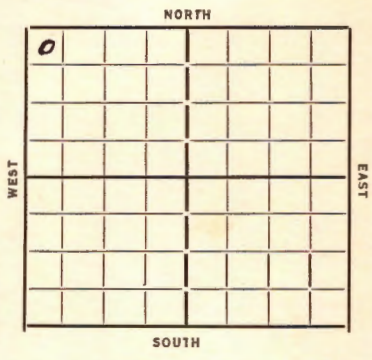

Date 1934

REPORT

8/1	Location
8/9	Rig
8/16	— 8/23 —
8/30	Spud
9/6	5" 980
9/13	8" 1247
9/20	" 2030 10" 1249
9/27	" 2485
10/4	2682 WR 6"
10/11	6" 2675 Cem 8" plug
10/18	2697 TD PB 2682 5 Hbls per day 1000 acid
10/25	8" 2735 TD 500' oil 2708-18 1000' oil 2721-34
11/1	—
11/8	2745 Inc oil TD 2776 1000 acid
11/15	— 11/22 —
11/27	TD 2776 1000 acid 39 oil 50 W.

COMPLETED

Map No. 39 Sec. 26 Twp. 25 R. 1W

Well No. 1-Underwood

Ted Spencer Company

Contractor

FIRST REPORTS

SECTION PLAT

330 Ft. from N. Line

_____ Ft. from S. Line,

_____ Ft. from E. Line

330 Ft. from W. Line

0			

Location ✓ RS

Rig up _____

Drilling and Remarks:

RECORD

Cased _____ in., _____ ft.

Sand _____

Gas _____

Oil _____

Total Depth _____

PRODUCTION

1st 24 hrs. Nat. _____

1st 24 hrs. after shot _____

Gas _____ Cu. Ft.

Dry Hole _____

Abandoned _____

Date

8-1-34 19

ORVAL MANNSCHRECK

Scout

KANSAS

Map No. 39 Sec. 26 Twp. 25 R. 1W

Well No. 1-Underwood

Spencer Company

Contractor

COMPLETED

SECTION PLAT

330 Ft. from N. Line

..... Ft. from S. Line

..... Ft. from E. Line

330 Ft. from W. Line

0			

Location.....

Rig up.....

Drilling and Remarks:

1000 and

39 oil
50 w

RECORD

Cased..... in., ft.

Sand.....

Gas.....

Oil.....

Total Depth 2776

PRODUCTION

1st 24 hrs. Nat.....

1st 24 hrs. after shot.....

Gas..... Cu. Ft.

Dry Hole.....

Abandoned.....

Date

11-27-37 192.....

ORVAL MANNSCHRECK

Scout