
O.W.W.O. Sedgwick KANSAS

SECTION 19 TOWNSHIP 25 RANGE 1 W

WELL NO. #1 Jones-~~Snow~~

COMPANY ~~Frey & Hilton Oil~~ Se-Ro-Bee

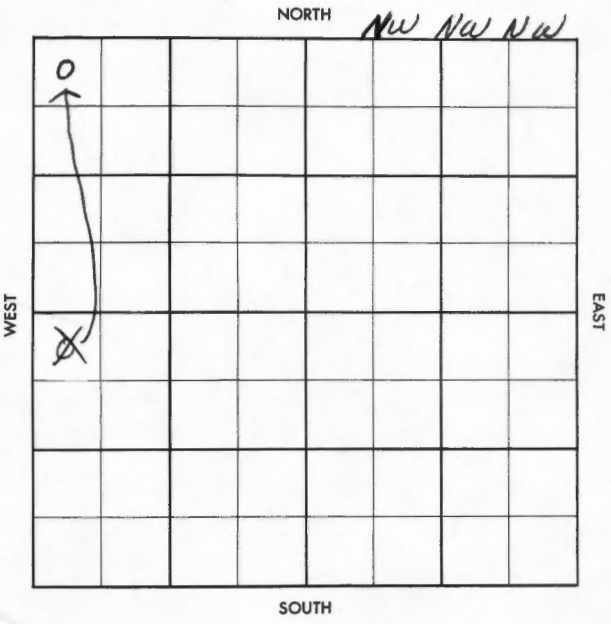

Sedgwick KANSAS

SEC.	TWP.	R.
19	25	1W

WELL NO.

#1 Jones-Snow FARM

COMPANY

Fry & Hinton Oil

CONTRACTOR

McKnab

Bentley


_____ Ft. from N. Line

_____ Ft. from S. Line

_____ Ft. from E. Line

_____ Ft. from W. Line

NW NW ~~SW~~ NW

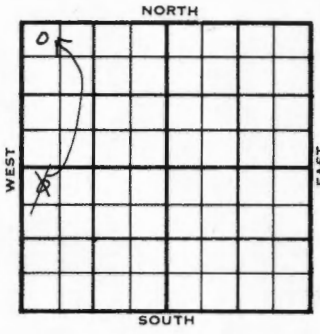

1955	ELEVATION 1376'	REPORT
11-30		Comm. 11-25-55 8" @ 319/200 Drlg. 1698
12-28		D & A H. 2236 Dg. 2269 BL. 2470 L. 2487 KC 2776 M. 3372 TD 3447'

ABANDONED

DX-78

O.W.W.O.

Twp. X Pool

Rge. X Feet

S-513-B

County Sedgwick Elev. 1376

Sec. 19 Twp. 25 Rge. 1W

Company Se-Ro-Bee (was Fry & Hinton

Farm Name Jones (#1 Jones-Snow) 1

TOPS	DEPTH	LOG	DATUM
Anh.			
Tp.			
H.			
Tr.			
Dg.			
B.L.			
L.	2487		
K.C.	~~2776~~		
B.K.C.			
Ce.			
C.			
M.	3372		
M.			
K.			
Mz.			
Mq.			
V.			
S.			
S.			
A.			
R.			
Pf.			
G.			
T.D.			

Loc. in Sec. NW NW NW

OWWO

Geol O.W.W.O

Contr.

Pool

0

ABANDONED

JUL 2 '58

Date Comm.

OTD 3447 MIR to wash down MAY 28 '58 3"

~~3000~~ WOCT JUN 3 '58 CO 3050

5" 3025/60 JUN 11 '58 JUN 16 '58 JUN 25 '58

JUL 2 '58 8/2926-28 PB 2905

8/2888-90 8/2890-94 H F

D&A

D&A

O.W.W.O.

S-513-B

County Sedgwick Elev. 1376

Sec. 19 Twp. 25 Rge. 1W

Company Se-Ro-Bee (was Fry & Hinton

Farm Name Jones (#1 Jones-Snow) 1

TOPS	DEPTH	LOG	DATUM
Anh.			
Tp.			
H.			
Tr.			
Dg.			
B.L.			
L.	2487		
K.C.	2776		
B.K.C.			
Ce.			
C.			
M.	3372		
M.			
K.			
Mz.			
Mq.			
V.			
S.			
S.			
A.			
R.			
Pf.			
G.			
T.D.			

Loc. in Sec. NW NW NW

ØWWO

Geol. O.W.W.O

Contr.

Pool

0

MAY 27

FIRST REPORT

Date Comm.

OTD 3447 MIR to wash down

Co. Lse. No. Sec. T. R.

SCOUT TICKET DX-201

SEC.	TWP.	R.
19	25	1W

WELL NO.

1 Jones-Snow — FARM

COMPANY

Fry & Hinton Oil

CONTRACTOR

CORRECTION


NW NW NW

330 FT. FROM N. LINE

_____ FT. FROM S. LINE

_____ FT. FORM E. LINE

330 FT. FROM W. LINE

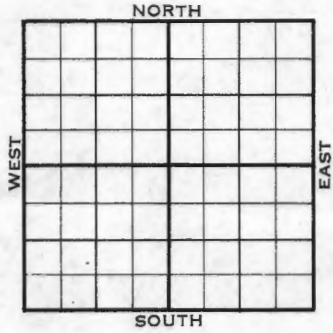

Sedgwick County

☐ LOCATION

☐ RIG UP

DRILLING AND REMARKS:

Reported
NW NW SW

RECORD

CASED IN., FT.

SAND

GAS

OIL

TOTAL DEPTH

PRODUCTION

1ST 24 HRS. NAT.

1ST 24 HRS. AFTER SHOT

GAS CU. FT.

DRY HOLE

ABANDONED

DATE	SCOUT
DEC 2 8 1955	

FORM 513 REV. SUNRAY

County Sedgwick Elev. 1376

Sec. 19 Twp. 25 Rge. 1W

Company Fry & Hinton Oil

Farm Name Jones-Snow No. 1

TOPS	DEPTH	LOG	DATUM
Anh.			
Tp.			
H.	2236		860
Tr.			
Dg.	2369		993
Bl.	2470		1094
L.	2487		1111
K.C.	2776		1400
B.K.C.			
Ce.			
C.			
M.	3372		1996
M.			
K.			
Mz.			
Mo.			
V.			
S.			
S.			
A			
R.			
P€.			
G.			
T.D.	3447		

Loc. in Sec. NW NW NW

Geol.

Contr. McKnab

Pool Bentley



Date Comm. 11-25-55 DEC 28 1955

8" @ 319/200

D & A

Co. Lse. No. Sec. T. R.

FORM 513 REV. SUNRAY

County Sedgwick Elev.

Sec. 19 Twp. 25 Rge. 1W

Company Fry & Hinton Oil

Farm Name Jones-Snow No. 1

TOPS	DEPTH	LOG	DATUM
Anh.			
Tp.			
H.			
Tr.			
Dg.			
Bl.			
L.			
K.C.			
B.K.C.			
Ce.			
C.			
M.			
M.			
K.			
Mz.			
Mo.			
V.			
S.			
S.			
A			
R.			
P€.			
G.			
T.D.			

Loc. in Sec. NW NW SW

Geol.

Contr. McKnab

Pool Bentley

FIRST REPORT

0

NOV 30 '55

Date Comm. 11-25-55

8¼ @ 319/200 drlg. 1698

Co. Lse. No. Sec. T. R.