


Section 19 Township 25 Range 1 W

Well No. # 1 Jones

Company Murray Pet.

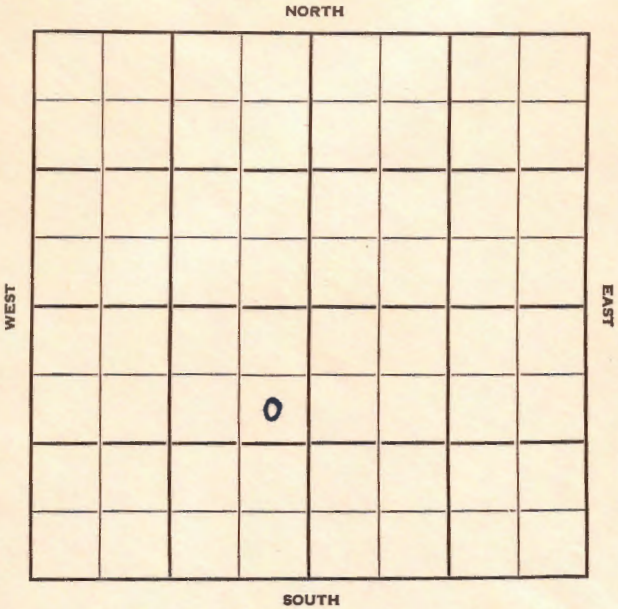


Sec. 19 Twp. 25 R. 1WWell No. 1 Jones FarmMurry Pet. CompanyUhl Drlg. Contractor990 Ft. from N. Line

Ft. from S. Line

330 Ft. from E. Line

Ft. from W. Line

SE NE SW

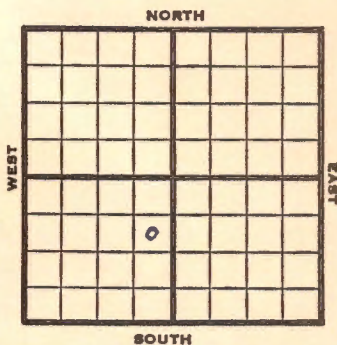1953 **Elev. 1368'** REPORT4/15 Spud 4-5-53
Lans 2485
Drlg **2710'**4/23 **KC 2862**
DST 2878-82 $\frac{1}{2}$ Hr. 170' M & W 1175#
DST 2917-20 275' SW 7350# **BKC 2949**
Drlg 3361'4/29 Spud 4-5-53
D & A TD 3514' **Lans 2485**
KC 2784
DST 2878-82 open $\frac{1}{2}$ hr rec 170' mud
& wtr. 1175#
DST 2917-20 rec 275' SW 1350#
B KC 2949 Miss 3356 TD 3514
D & A**ABANDONED**

