


Sedgwick

Map No. **KANSAS** Sec. *19* Twp. *25* R. *1^W*

Well No. *1-Jones* Farm

Van Zandt Co. Company

NORTH

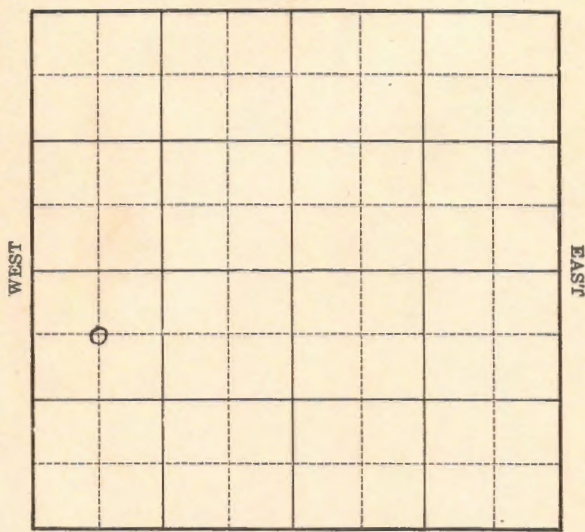

SOUTH

Location _____

Drilling Remarks _____

Rig Up _____

Drilling Remarks _____

RECORD

Cased _____ in. _____ ft.

Sand _____

Gas _____

Oil _____

Total Depth _____

PRODUCTION

1st 24 hrs. Nat. _____

1st 24 hrs. after shot _____

Gas _____ cu. ft.

Dry Hole _____

Abandoned _____

Sedgwick

Map No. **KANSAS** Sec. 19 Twp. 25 R. 1^W

Well No. 1 - Jones Farm


Van Zandt et al Company

660 Ft. from N. Line

..... Ft. from S. Line

..... Ft. from E. Line

660 Ft. from W. Line

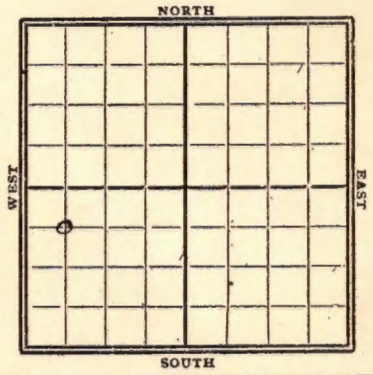

1928

Date

REPORT

10/3	Rig
10/10	Spud
10/17	Spud 150'
10/24	drlg 585'
10/31	" 1200'
11/7	" 1450'
11/14	S.D. 2160' T.D.
11/21	U/R 10" at 2165'
11/28	drlg 2400'
12/5	" 2615'
12/12	" 2750'
12/19	S.D. 2775'-T.D.
12/26	drlg 2825'
1929	
1/2	Pay 2905-16' shutdown 600' oil in hole
1/9	U/R 8"-2994'-T.D.
1/16	fg pipe 3030'-T.D.
1/23	drlg 3035'
1/30	" 3200'
2/6	Top line 3390' drlg 3415'

- 2/13- fsg took 3431' T.D.
2/19 - Measured T.D. 3504' in
Mississippi lime
Telegram
2/20- Top Miss lime 3390'
T.D. 3504'
Measured by J. Lewis
2/20- HFW-3495-3504
T.D. 3504 in Miss
2/27- HFW-3495-3504'
T.D. 3504'
Dry & abandon

Beaquick
 AP NO. 10580 SEC. 19 TWP. 25 R. 1W
 WELL NO. Jones
Van Gandt & Dal COMPANY
 _____ CONTRACTOR

SECTION PLAT

0			

660 FT. FROM N. LINE
 _____ FT. FROM S. LINE
 _____ FT. FROM E. LINE
660 FT. FROM W. LINE

FIRST REPORTS

LOCATION _____

 BILLING AND REMARKS:

Rig

RECORD

CASED _____ IN. _____ FT.
 SAND _____
 GAS _____
 OIL _____
 TOTAL DEPTH _____

PRODUCTION

1ST 24 HRS. NAT. _____
 1ST 24 HRS. AFTER SHOT _____
 GAS _____ CU. FT.
 DRY HOLE _____
 ABANDONED _____

DATE

OCT 3 1928

S. J. LEWIS

192

SCOUT

MAP No. **KANSAS** SEC. 19 TWP. 25 R. 1W

WELL No. 1 Jones

Van Zandt & Co COMPANY

CONTRACTOR

SECTION PLAT

660 FT. FROM N. LINE

_____ FT. FROM S. LINE

_____ FT. FROM E. LINE

660 FT. FROM W. LINE

0			

ABANDONED

LOCATION _____

RIG UP _____

DRILLING AND REMARKS:

HPW 3495-3504

IIA

RECORD

CASED _____ IN., _____ FT.

SAND _____

GAS _____

OIL _____

TOTAL DEPTH 3504

PRODUCTION

1ST 24 HRS. NAT. _____

1ST 24 HRS. AFTER SHOT _____

GAS _____ CU. FT.

DRY HOLE _____

ABANDONED _____

DATE

FEB 27 1929

S. J. LEWIS

192_____

SCOUT