


KANSAS

Sedgwick

Section 22 Township 25 Range 1W

Well No. 1 Jacobs

Company A. D. Allison

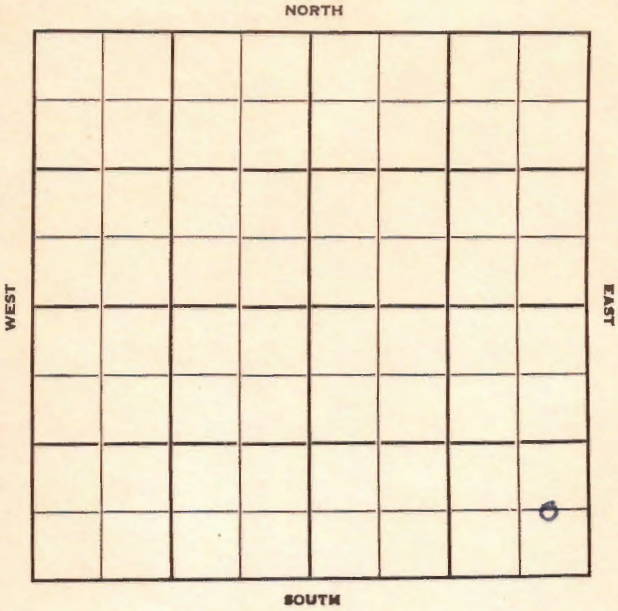

Sedgwick

KANSAS



Sec. 22 Twp. 25 R. 1W

Well No. #1 Jacobs Farm _____

A. D. Allison Company _____

Miscellaneous


_____ Ft. from N. Line

660' Ft. from S. Line

330' Ft. from E. Line

_____ Ft. from W. Line

C E L S E S E

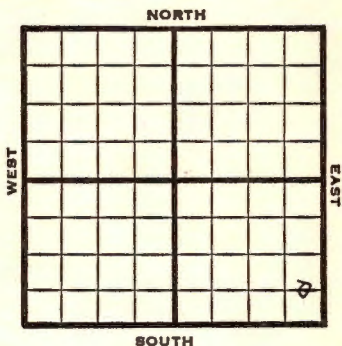

1949

Elev 1360'

R E P O R T

6/15

Twin Well
Spud

6/21

Drlg. 1415'

6/28

Drlg. 1415'

7/6

KC 2678'

TD 2717

5" @ 2711'

7/13

TD 2720'

KC 2678'

Aband.

ABANDONED

Sedgwick County Kansas State

Map No. _____ Sec. 22 Twp. 25 R. 1W

Well No. 1 Jacobs

A. D. Allison Company

Contractor

C E L SE SE

FIRST REPORT
SECTION PLAT

_____ Ft. from N. Line

660 Ft. from S. Line

330 Ft. from E. Line

_____ Ft. from W. Line

Miscellaneous

Remarks:

twin well spud

Date
JUN 15 1949

Scout
S. J. LEWIS

Map No. K39 Sec. 22 Twp. 25 R. 1W

Well No. 1 Jacobs

A. D. Allison Company

ABANDONED

Contractor

C E L S E S E

2/13/66
SECTION PLAT

 Ft. from N. Line

660 Ft. from S. Line

330 Ft. from E. Line

 Ft. from W. Line

Sedgwick County

RECORD

Location

Cased in., ft.

Rig up

Sand

Drilling and Remarks:

Gas

Hc2675

Oil

Total Depth 2720

PRODUCTION

1st 24 hrs. Nat.

1st 24 hrs. after shot

Gas Cu. Ft.

Dry Hole

Abandoned

Date

JUL 13 1949 19

S. J. LEWIS Scout