


Section 22 Township 25 Range 1-W

Well Number 1 Smith

Company Windsdor Oil

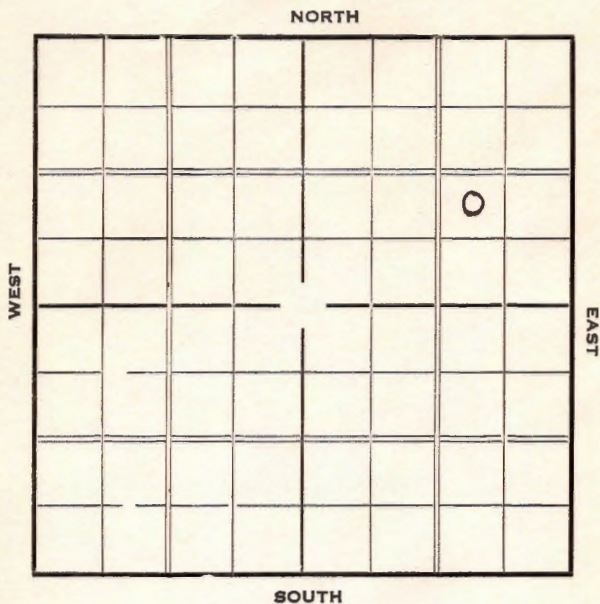

Sec. 22 Twp. 25 R. 1-W

Well No. #1 Smith Farm
Windsor Oil Company


 Ft. from N. Line

990 Ft. from S. Line

990 Ft. from E. Line

 Ft. from W. Line

Elev. 1358

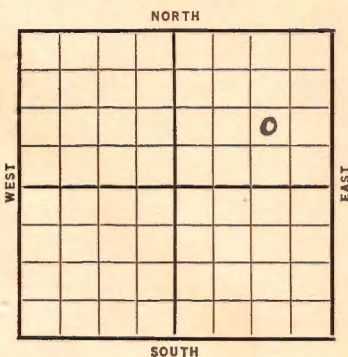

Date	REPORT
1937	
2/17	Rigging up.
2/26	" "
3/4	" "
3/11	" "
3/18	15" @ 84' Shut Down
3/25	" " " "
4/2	15" @ 110'. Drlg. 750'.
4/8	Shut Down 750'.
4/16	" " "
4/23	" " "
4/30	" " "
5/7	" " "
5/14	SD 750'.
5/21	" "
5/28	" "
6/4	" "
6/11	" "
6/19	" "
6/25	10" @ 1420'. Drlg. 2085'.
7/2	Drlg. 2515'. H.F.W.
7/9	8" @ 2628'. T.D. 2661'.
	U. R. 8". OVER

1937
 7/15 8" @ 2755'. T.D. 2817' H.R.
 7/23 SD @ 3161'.
 7/30 " " "
 8/6 " " "
 8/13 " " "
 8/20 Miss. 3173'. T.D. 3242' SD.
 8/28 " " " " "
 9/3 " " " " "

9/8 Sil. 4089'.
 T.D. 4150'.
 D & A.

ABANDONED

Map No. 39 Sec. 22 Twp. 25 R. 1W

Well No. 1 Smith

Hinsdale Oil Company

Contractor

SECTION PLAT

			0

_____ Ft. from N. Line

990 Ft. from S. Line

990 Ft. from E. Line

_____ Ft. from W. Line

FIRST REPORT

Location _____

Rig up _____

Drilling and Remarks:

Rigging up

RECORD

Cased _____ in., _____ ft.

Sand _____

Gas _____

Oil _____

Total Depth _____

PRODUCTION

1st 24 hrs. Nat. _____

1st 24 hrs. after shot _____

Gas _____ Cu. Ft.

Dry Hole _____

Abandoned _____

Date

FEB 17 1937

19

S. J. LEWIS

Scout

Map No. 39 Sec. 22 Twp. 25 R. 1W

Well No. 1 - Smith

Windsor oil Company

Contractor

ABANDONED

SECTION PLAT

			0

_____ Ft. from N. Line

990 Ft. from S. Line

990 Ft. from E. Line

_____ Ft. from W. Line

Location _____

Rig up _____

Drilling and Remarks:

10 + 7

RECORD

Cased _____ in., _____ ft.

Sand Sil 4089

Gas _____

Oil _____

Total Depth 4150

PRODUCTION

1st 24 hrs. Nat. _____

1st 24 hrs. after shot _____

Gas _____ Cu. Ft.

Dry Hole _____

Abandoned _____

Date

H. D. Hatfield

SEP 8 1937 19

Scout