

KANSAS

Sedgwick

Section 23 Township 25 Range 1W

Well No. #1 Clark

Company Carlock etal.
Wildcat

NORTH

WEST

EAST

				②			

SOUTH

Sec. 23 **KANSAS** Twp. 25 R. 1W

Well No. #1 Clark Farm
Carlock et al Company


Wildcat

330 Ft. from N. Line

_____ Ft. from S. Line

_____ Ft. from E. Line

330 Ft. from W. Line

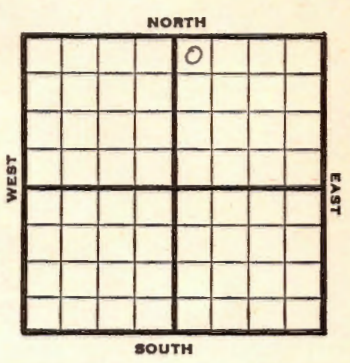

NW NE

1948

Elev. - REPORT

4/21

RUR

4/28

8" @ 159'

Lansing 2367'

Drlg. 2566'

5/5

Lansing 2367'

TD 2750'

ABANDONED

Map No. _____ Sec. 23 Twp. 25 R. 1W

Well No. 1 Clark

Carlock etal. Company

-IRST REPORT Contractor

NW NE

SECTION PLAT

330 Ft. from N. Line

_____ Ft. from S. Line

_____ Ft. from E. Line

330 Ft. from W. Line

		o	

Sedgwick County

Location _____

Rig up _____

Drilling and Remarks:

R U R

RECORD

Cased _____ in., _____ ft.

Sand _____

Gas _____

Oil _____

Total Depth _____

PRODUCTION

1st 24 hrs. Nat. _____

1st 24 hrs. after shot _____

Gas _____ Cu. Ft.

Dry Hole _____

Abandoned _____

Date

APR 21 1948 19

S. J. LEWIS Scout

Map No. 39 Sec. 23 Twp. 25 R. 1W

Well No. 1 Clark

Carlock etal. Company

ABANDONED Contractor

NW NE

SECTION PLAT

330 Ft. from N. Line
 Ft. from S. Line
 Ft. from E. Line
330 Ft. from W. Line

		8	

Sedgwick County

Location

Rig up

Drilling and Remarks:

Lane 2367

RECORD

Cased in., ft.
Sand
Gas
Oil
Total Depth 2250

PRODUCTION

1st 24 hrs. Nat.
1st 24 hrs. after shot
Gas Cu. Ft.
Dry Hole
Abandoned

Date

MAY 5 1948 19 S. J. LEWIS Scout