


Sedgwick

Map No. _____ Sec. 23 Twp 25 R. 1W

Well No. 1 Underwood Farm
Faulkner et al Company

_____ Ft. from N. Line
660 Ft. from S. Line
_____ Ft. from E. Line
660 Ft. from W. Line

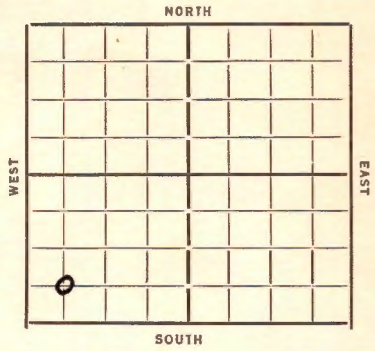

Date 1924

REPORT

<u>5/9</u>	<u>Rign up</u>		
<u>5/18</u>	<u>Dly 175</u>	<u>15 1/2</u>	<u>100</u>
<u>5/25</u>	<u>" 800</u>		
<u>5/31</u>	<u>SD 1000</u>		
<u>6/7</u>	<u>— 6/14</u>	<u>— 6/21</u>	<u>—</u>
<u>6/28</u>	<u>— 7/5</u>	<u>— 7/12</u>	<u>—</u>
<u>7/19</u>	<u>— 7/26</u>	<u>— 8/2</u>	<u>—</u>
<u>8/9</u>	<u>— 8/16</u>	<u>— 8/23</u>	<u>—</u>
<u>8/30</u>	<u>— 9/6</u>	<u>— 9/13</u>	<u>—</u>
<u>9/20</u>	<u>— 9/27</u>	<u>— 10/4</u>	<u>—</u>
<u>10/10</u>	<u>abl TD 1029.</u>		

ABANDONED

KANSAS

Map No. 39 Sec. 23 Twp. 25 R. 1W

Well No. 1-Underwood

Frankner et al Company

Contractor

FIRST REPORTS

SECTION PLAT

0			

_____ Ft. from N. Line

660 Ft. from S. Line

_____ Ft. from E. Line

660 Ft. from W. Line

Location _____

Rig up _____

Drilling and Remarks:

Rig up

RECORD

Cased _____ in., _____ ft.

Sand _____

Gas _____

Oil _____

Total Depth _____

PRODUCTION

1st 24 hrs. Nat. _____

1st 24 hrs. after shot _____

Gas _____ Cu. Ft.

Dry Hole _____

Abandoned _____

Date

5-9-37 19

ORVAL MANNSCHRECK Scout

Map No. 39 Sec. 23 Twp. 25 R. 1W

Well No. 1-Underwood

Frankner et al Company

Contractor

ABANDONED

SECTION PLAT

0			

Ft. from N. Line

660

Ft. from S. Line

Ft. from E. Line

660

Ft. from W. Line

Location.....

Rig up.....

Drilling and Remarks:

abd

RECORD

Cased.....in.,ft.

Sand.....

Gas.....

Oil.....

Total Depth 1029

PRODUCTION

1st 24 hrs. Nat.....

1st 24 hrs. after shot.....

Gas.....Cu. Ft.

Dry Hole.....

Abandoned.....

Date

10-10-37

192.....

ORVAL MANNSCHECK

Scout