


Sedgwick

KANSAS

SECTION 25 TOWNSHIP 25S RANGE 1W

WELL NO. #2 Updegraff

COMPANY Aladdin Petro.

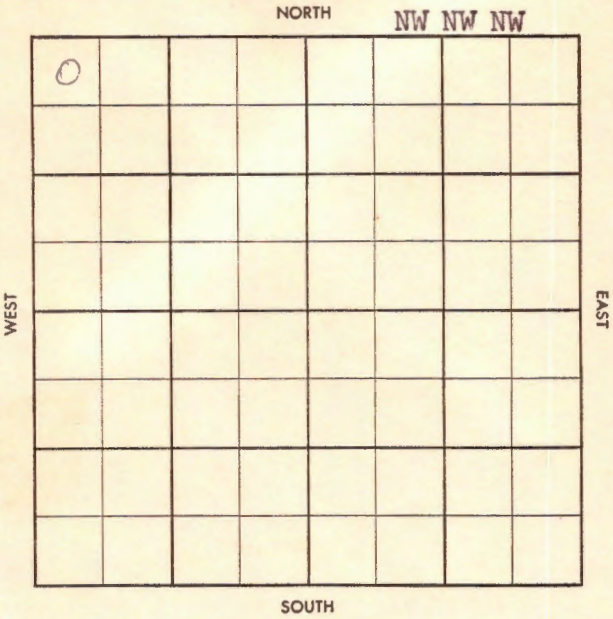

~~Twp. Pool~~

WILDCAT

28

S-513-B

County Sedgwick Elev. _____
 Sec. 25 Twp. 25 Rge. 1W
 Company Aladdin Pet.
 Farm Name Updegraff No. 2

TOPS	DEPTH	LOG	DATUM
Anh.			
Tp.			
H.			
Tr.			
Dg.			
B.L.			
L.			
K.C.			
B.K.C.			
Ce.			
C.			
M.			
M.			
K.			
Mz.			
Mq.			
V.			
S.			
S.			
A.			
R.			
Pf.			
G.			
T.D.			

Loc. in Sec. NW NW NW
 Geol. _____
 Contr. Bedell-Ca
 Pool Wildcat

JUN 18 1958
FIRST REPORT

Date Comm. 6-13-58
8" @ drlg. 1805

Co.

No.

Sec.

T

S


Twp. ~~X~~ Pool ~~X~~
 Co. ~~X~~ Foot ~~X~~

S-513.B

County Sedgwick Elev. 1356 DF 1359 RB
 Sec. 25 Twp. 25 Rge. 1W
 Company Aladdin Pet.
 Farm Name Updegraff No. 2

TOPS	DEPTH	LOG	DATUM
Anh.			
Tp.			
H.			
Tr.			
Dg.			
B.L.			
L.	<u>2378</u>		
K.C.	<u>5615</u>		
B.K.C.	<u>5150</u>	<u>3108</u>	
Ce.			
C.			
M.	<u>du/a</u>	<u>3194</u>	
M.	<u>Li</u>	<u>3193</u>	
K.		<u>3506</u>	
Mz.	<u>Hunt</u>	<u>3583</u>	
Mq.		<u>3599</u>	
V.			
S.			
S.			
A.			
R.			
Pf.			
G.			
T.D.	<u>3608</u>		

Loc. in Sec. NW NW NW
 Geol. _____
 Contr. Bedell-Catt
 Pool Wildcat

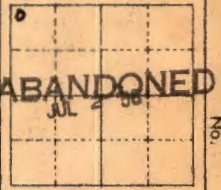

Date Comm. 6-13-58
8" @ 185 drlg. 1805 JUN 25 58 DST
2671-92 15" 15' M FPO-0 BHP
1035/15" DST 2708-23 1hr 20'
50CM 60' MSW FPO-30 BHP
105420 4 3434 JUL 2 58 DST 3583-87
30" 378 sulph W FPI5-155 BHP 1280/20
no log

D6A