


Sedgwick

Form 51-5M-11-31-Palace

Map No. **KANSAS** Sec. *27* Twp. *25* R. *14*

Well No. *1* *Cross* Farm
D. J. Connell Company

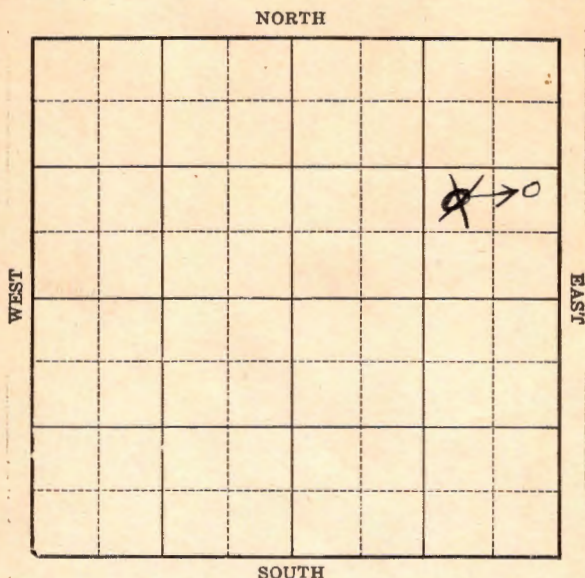

Location _____

Drilling Remarks _____

Rig Up _____

Drilling Remarks _____

RECORD

Cased _____ in. _____ ft.

Sand _____

Gas _____

Oil _____

Total Depth _____

PRODUCTION

1st 24 hrs. Nat. _____

1st 24 hrs. after shot _____

Gas _____ cu. ft.

Dry Hole _____

Abandoned _____

Sedgwick

Map No. **KANSAS** Sec. 27 Twp. 25 R. 1W

Well No. 1 Cross Farm

A. J. Connell
O. J. Connell Company


Ft. from N. Line

990 Ft. from S. Line

330

990 Ft. from E. Line

Ft. from W. Line

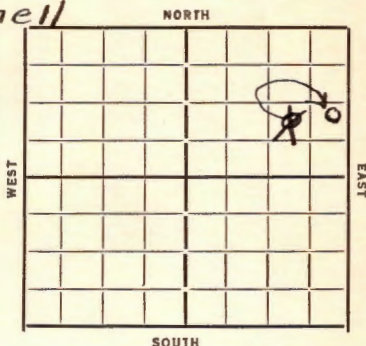

Date

REPORT

5/30 Rig
6/7 — 6/14 — 6/21 —
6/28 — 7/5 —
7/12 Rgn up
7/19 15" 94 12" 228 dly 850
7/26 10" 1235
8/2 dly 2130 8" 2120
8/9 2655 pipe collapsed.
8/16 2690 Run 5"
8/22 TD 2761 d & A

ABANDONED

Map No. 39 Sec. 27 Twp. 25 R. 1W

Well No. 1-Cross

O. J. Connell Company

Contractor

ABANDONED

SECTION PLAT

KANSAS			

 Ft. from N. Line

990 Ft. from S. Line

330 Ft. from E. Line

 Ft. from W. Line

Location

Rig up

Drilling and Remarks:

10 + A

RECORD

Cased in., ft.

Sand

Gas

Oil

Total Depth 2761

PRODUCTION

1st 24 hrs. Nat.

1st 24 hrs. after shot

Gas Cu. Ft.

Dry Hole

Abandoned

Date

8-22-34 19

ORVAL MANNSCHRECK Scout

Map No. 39 Sec. 27 Twp. 25 R. 1NWell No. 1 CrossD. J. Connell Company

Contractor

SECTION PLAT

			0

FIRST REPORTS

 Ft. from N. Line990 Ft. from S. Line990 Ft. from E. Line Ft. from W. LineLocation Rig up

Drilling and Remarks:

Rig

RECORD

Cased in., ft.Sand Gas Oil Total Depth

PRODUCTION

1st 24 hrs. Nat. 1st 24 hrs. after shot Gas Cu. Ft.Dry Hole Abandoned

Date

5/201934

ORVAL MANNSCHRECK Scout

Map No. 39 Sec. 27 Twp. 25 R. 1W

Well No. 1-Cross

O. J. Connell Company

Contractor

CORRECTION

SECTION PLAT

			0 →

_____ Ft. from N. Line

990 Ft. from S. Line

330 Ft. from E. Line

_____ Ft. from W. Line

CORRECTION

Location _____

Rig up _____

Drilling and Remarks: 40

RECORD

Cased _____ in., _____ ft.

Sand _____

Gas _____

Oil _____

Total Depth _____

PRODUCTION

1st 24 hrs. Nat. _____

1st 24 hrs. after shot _____

Gas _____ Cu. Ft.

Dry Hole _____

Abandoned _____

CORRECTION

Date _____

ORVAL MANNSCHRECK

19 _____

Scout

formerly reported NW 1/4 N 1/4 E 1/4