

KANSAS

FORM 51 5M 10-41 PETROL

Reno

Section 15 Township 25 Range 10-W

Well No. #1 Nies

Company Mid-States

NORTH

0							

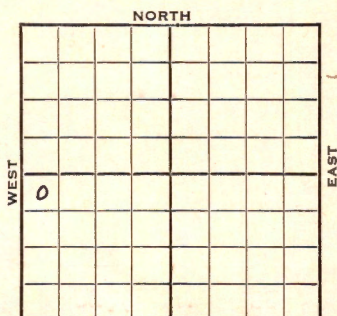
SOUTH

WEST

EAST

Sec. 15 Twp. 25 R. 10-WWell No. #1 Nies FarmMid-States Company

Wildcat

330 Ft. from N. Line Ft. from S. Line Ft. from E. Line330 Ft. from W. Line

NW SW

Elev. 1752 DF 1749 Gr. (Est)

1943

REPORT

1/13	Rotary.
1/20	158' SD.
1/27	10" Casing set 160' WOC.
2/3	" " "
2/10	" " "
2/17	" " "
2/24	" " "
3/3	" " "
3/10	" " "
3/17	Drlg. 1990'
3/24	Anhy 440 Ft Riley 1770 Drlg. 2715'
3/31	Drlg. 3395'
4/7	Topeka 2930 Lans 3478 Drlg. 3762
4/14	Miss 3907 B. Miss 3966 Kind 3986 Drlg. 4064'

OVER

1943

4/21

Viola 4141

Simp 4234

Arb 4313

Drlg. 4338 No show.

4/28

Arb. 4313

T.D. 4367'

No shows.

ABANDONED

Reno

KANSASMap No. 47 Sec. 15 Twp. 25 R. 10WWell No. 1 NiesMid-States

Company

FIRST REPORT

Contractor

NW SW

SECTION PLAT

330

Ft. from N. Line

Ft. from S. Line

Ft. from E. Line

330

Ft. from W. Line

o			

WILDCAT

Location

Rig up

Drilling and Remarks:

Rotary

RECORD

Cased _____ in., _____ ft.

Sand _____

Gas _____

Oil _____

Total Depth _____

PRODUCTION

1st 24 hrs. Nat. _____

1st 24 hrs. after shot _____

Gas _____ Cu. Ft.

Dry Hole _____

Abandoned _____

Date

JAN 13 1943 19S. J. LEWIS Scout

Reno

KANSAS
 Map No. 77 Sec. 15 Twp. 25 R. 10W

Well No. 1 Nies

Mid-States

Company

ABANDONED

Contractor

NW SW

SECTION PLAT

330 Ft. from N. Line Ft. from S. Line Ft. from E. Line330 Ft. from W. Line

6			

WILDCAT

Location Rig up

Drilling and Remarks:

Cor 74318
Nashville

RECORD

Cased in., ft.Sand Gas Oil Total Depth 4367

PRODUCTION

1st 24 hrs. Nat. 1st 24 hrs. after shot Gas Cu. Ft.Dry Hole Abandoned

Date

APR 28 1943 19

S. J. LEWIS Scout