


Section 20 Township 25 Range 10WWell No. 1 NiesCompany Schermerhorn Oil

NORTH

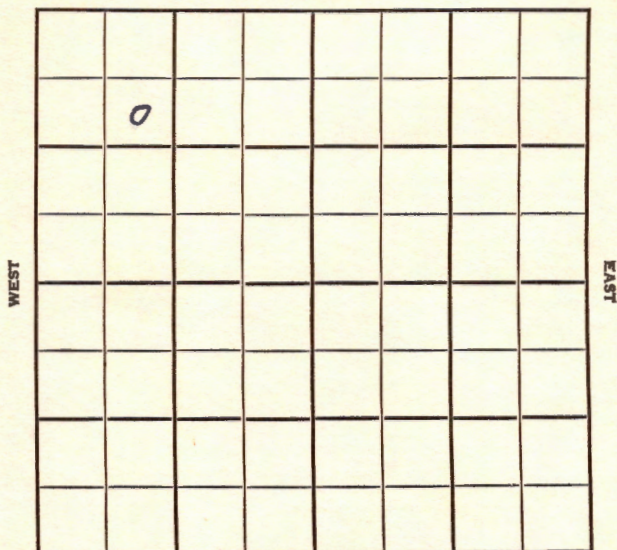

SOUTH

Reno

KANSAS

SEC.	TWP.	R.
20	25	10W ✓

WELL NO.

#1 Nies

FARM

COMPANY

Schermmerhorn Oil

CONTRACTOR

Badger

Wildcat.

990


Ft. from N. Line

Ft. from S. Line

Ft. from E. Line


990

Ft. from W. Line

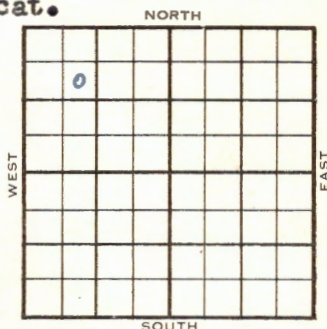

SE NW NW

	ELEVATION	REPORT
1954	1789'	
5/12	Spud 5-7-54 8" @ 336' Drlg 1715'	
5/19	Heeb 3302', Lans 3504' DST 3537-84' 1 hr, 1440' SW Drlg 3731'	
5/26	Spud 5-7-54 D & A TD 4390 8" @ 336 Heeb 3302 Lans 3504 DST 3537-84 open 1 hr rec 1440' SW Miss 3952' DST 3948-80 open 2 hr rec 330' VSO & GCM, Viola 4156 DST 4159-68 open 2 hr rec 1380' sul. wtr. 605# imp. 4259' DST 4260-90 open 1 hr rec 8' mud. 850# Arb. 4337 TD 4390' D & A	
ABANDONED		

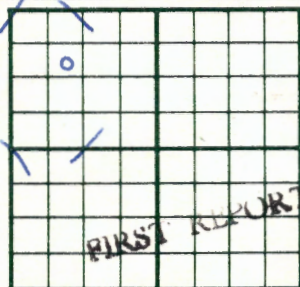
County **René** State **Kansas**Sec. **20** (Blk. Twp.) **25** (Sur. Rge.) **10W** Map No.Operator **Schermerhorn Oil**Well No. **1** Farm **Nies**Elev. Location **SE NW NW**990 Ft. From **N** Line **NW**990 Ft. From **W** Line Quarter1st. Report **MAY 12 1954**

Completion

Remarks

Badger - Contr.Spudding Date **5-7-54**Drlg. Data **Wildcat****8" @ 336 drlg. 1715****J. G. McGEHEE**

County Reno State Kansas
 Sec. 20 (Blk. 25) (Sur. 10W) (Twp.) (Rge.) Map No.
 Operator Schermerhorn Oil
 Well No. 1 Farm Nies
 Elev. 1789 Location SE NW NW

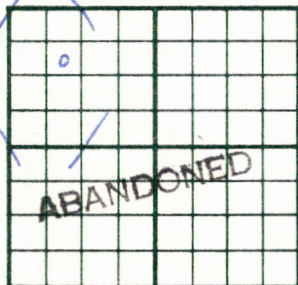

990 Ft. From N Line NW
 990 Ft. From W Line Quarter
 1st. Report
 Completion MAX 2 6 = 13554
 Remarks Wildcat
Badger - Contr.
 Spudding Date 5-7-54

Drlg. Data D & A TD 4390
8" @ 336 Heeb. 3302 Lans. 3504
DST 3537-84 open 1 hr. Rec. 1440' sw
Miss. 3952 DST 3948-80 open 2 hr.
Rec. 330' vso & gcm Viola 4156
DST 4159-68 open 2 hr. Rec. 1380'
sul. wtr. 605# Simp. 4259 DST 4260-90
open 1 hr. Rec. 8' mud 850# Arb. 4337
TD 4390

D & A

J. G. McGEHEE