


Section 31 Township 25 Range 10 W

Well No. #1 Zink

Company L. C. Smitherman

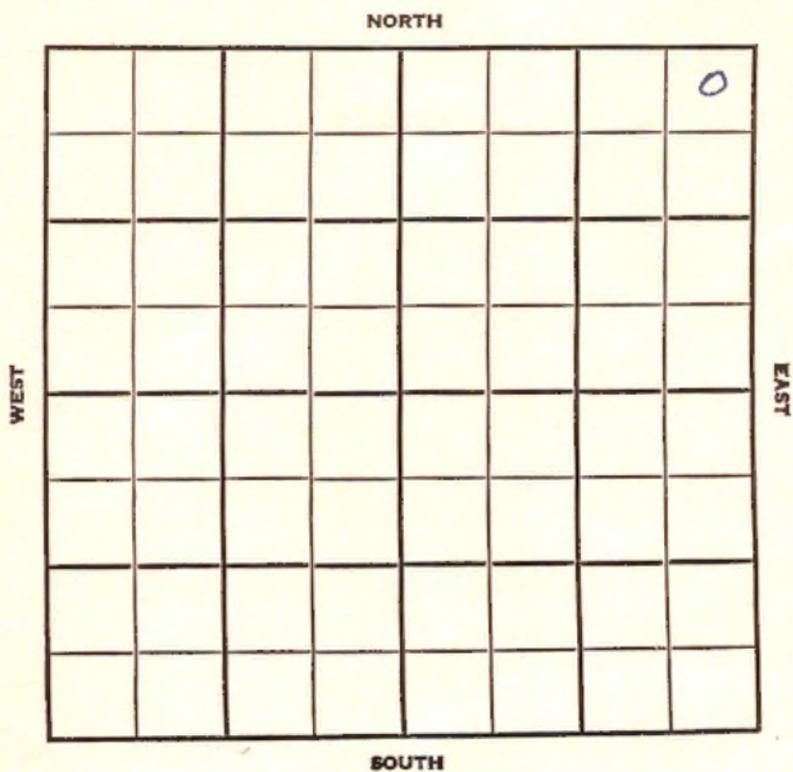

Reno

KANSAS

SEC. 31	TWP. 25	R. 10W
------------	------------	-----------

WELL NO.

#1 Zink

FARM

COMPANY

L.C. Smitherman

CONTRACTOR

Co. Tools

WILDCAT

_____ Ft. from N. Line

_____ Ft. from S. Line

_____ Ft. from E. Line

_____ Ft. from W. Line



NE NE NE

5/8 mile - SDX

Aurora - DHM

	ELEVATION	REPORT
1956	### 1784 DF	
2-22	Comm. 2-14-56 8" @ 320/300 Drlg. 2980	
3-1	Heeb. 3318, Tor. 3333 Doug. sd. 3405 Br. lime 3498, Lans. 3512, Miss. Chert 3961 Viola 4194, DST 3963-83, op 1 hr. rec. 30' XXXXXXXXXX sgc&vsocm, 95/20" Drlg. 4202	

~~1780-27~~

County Rego Elev. 1789 1788DF
 Sec. 31 Twp. 25 Rge. 10W
 Company L. C. Smitherman
 Farm Name Zink No. 1

TOPS	DEPTH	LOG	DATUM	Loc. in Sec.
Ant.				NE NE NE
Tp.				
H.	3318			
Tr.	3333			
Dp. <i>sd</i>	3405			
Bl.	3498			
L.	3512		1784	Geol.
K.C.				Conts.
B.K.C.				
Ce.				Co. tools
C.				
N. <i>cheer</i>	3961		2173	Pool
M.				Wildcat
K.	4035		2236	
Mz.				
Ma.				
V.	4194		2405	MAR 7 1956
S.	4288		2500	
S. <i>sd</i>	4300		2511	
A.	4370		2522	
R.				
PC.				
G.				ABANDONED
TD.	4407			

Date Comm. 2-11-56 Aurora - DHM
 8" @ 320/300 drlg. 2980 FEB 29 '56

UST 3963-83 1hr rec 30'
 SEC & VSOCM BMP 95/20"
 # 4202 MAR 7 '56 Ran Log

AL & A

County Reno Elev. 1789
 Sec. 31 Twp. 25 Rge. 10W
 Company L. O. Smitherman
 Farm Name Zink No. 1

TOPS	DEPTH	LOG	DATUM	Loc. in Sec.
Anb.				NE NE NE
Tr.				
Dg.				
Bl.				
L.				Geol.
K.C.				Contr.
B.K.C.				Co. tools
Ce.				Pool
C.				Wildcat
M.				
M.				
K.				
Mz.				
Me.				
V.				
S.				
S.				
A.				
R.				
Pe.				
G.				
T.D.				

0
 5/7 mile
 FIRST REPORT
 FEB 22 '56

Date Comm. 2-14-56 Aurora - DHM
 8" @ 320/300 drlg. 2980

Handwritten mark: a large blue arrow pointing down and to the right, with the number '27' written below it.

Co.
 Lse.
 No.
 Sec.
 T.
 R.