

KANSAS


Stafford

FORM 51 5M 1-42 PETROL

Section 31 Township 25 Range 11-W

Well No. #1 Freymiller

Company Franco Central & Hinkle

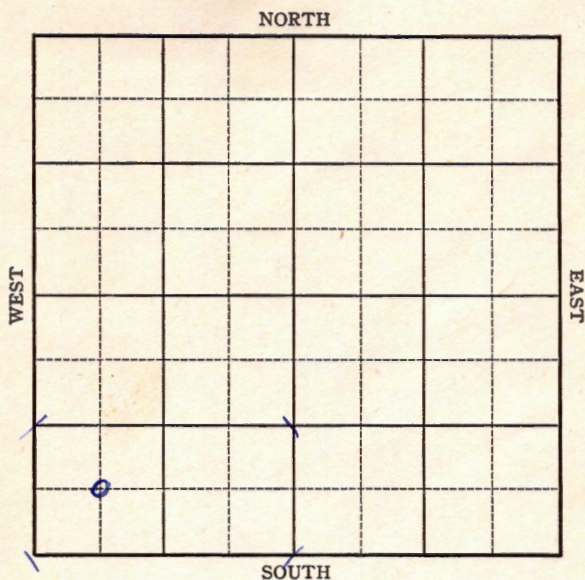


KANSAS

Stafford

Sec. 31 Twp. 25 R. 11-WWell No. #1 Freymiller FarmFranco Central & Hinkle Company

NORTH

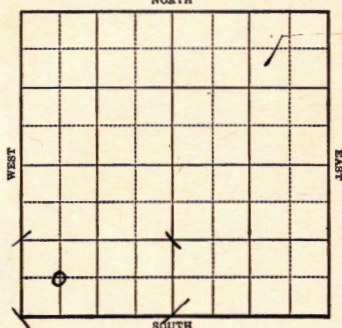

_____ Ft. from N. Line

660 Ft. from S. Line

_____ Ft. from E. Line

660 Ft. from W. LineElev. 1861 L+S

SOUTH

1943

R E P O R T

9/29

Derrick

10/6

"

10/23

"

10/20

10" @ 284 & 665

1250' lost circulation

10/27

Drlg. 1750'

11/3

Drlg. 3035'

11/10

Lans 3565

SSO 3700-20 3749-52

Drlg. 3757'

11/17

Miss 3922

Misener 4070

Viola 4073

SSO 4083-85

Simp 4154

Simp Sd 4185

Drlg. 4192'

11/24

Arb 4251

Water

TD 4086'

4073
1861
2212

ABANDONED

KANSAS

Stafford

Map No. 47 Sec. 31 Twp. 25 R. 11W

Well No. 1 Freymiller

Franco Central & Hinkle Company

ABANDONED

Contractor

C SW SW

SECTION PLAT

 Ft. from N. Line

660 Ft. from S. Line

 Ft. from E. Line

660 Ft. from W. Line

0			

Wildcat

Location

Rig up

Drilling and Remarks:

Per #4251

Water

RECORD

Cased in., ft.

Sand

Gas

Oil

Total Depth 4086

PRODUCTION

1st 24 hrs. Nat.

1st 24 hrs. after shot

Gas Cu. Ft.

Dry Hole

Abandoned

Date

NOV 24 1943

19


S. J. LEWIS

Scout

Map No. KANSAS Sec. 31 Twp. 25 R. 11WWell No. 1 FreymillerFranco Central & Hinkle CompanyFIRST REPORT Contractor

C SW SW

SECTION PLAT

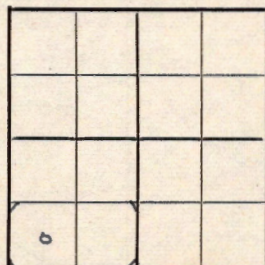 Ft. from N. Line660 Ft. from S. Line Ft. from E. Line660 Ft. from W. LineWildcatLocation Rig up

Drilling and Remarks:

Derrick

RECORD

Cased in., ft.Sand Gas Oil Total Depth

PRODUCTION

1st 24 hrs. Nat. 1st 24 hrs. after shot Gas Cu. Ft.Dry Hole Abandoned

Date

SEP 29 1943

19

S. J. LEWIS

Scout