



KANSAS

Stafford

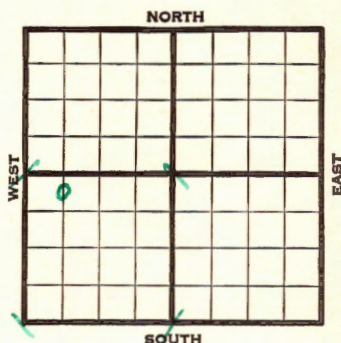
Sec. 29 Twp. 25 R. 11-WWell No. #1 Thomas FarmChamplin Refg. Company

(Wildcat)

330 Ft. from N. Line

Ft. from S. Line

Ft. from E. Line

660 Ft. from W. Line*Elev. 1834*

| 1941  | REPORT                       |
|-------|------------------------------|
| 12/23 | Derrick.                     |
| 12/31 | Surface hole.                |
| 1942  |                              |
| 1/8   | 8" - 248' Ft. Riley 1930'    |
|       | Florence 2030' Wreford 2130' |
|       | Topeka 300 ??? Drlg.         |
| 1/15  | Lans. 3580' B.K.C. 3920'     |
|       | Miss. 3950' Viola 4123'      |
|       | Drlg. 4150'                  |
| 1/21  | Simpson 4210'                |
|       | Arb. 4277'                   |
|       | T.D. 4288'                   |
|       | No shows.                    |
|       | ABANDONED                    |

Stafford

KANSAS

Map No. 47 Sec. 29 Twp. 25 R. 11WWell No. 1 ThomasChamplin Refining CompanyFIRST REPORT Contractor

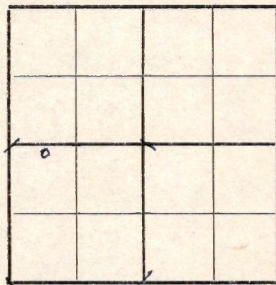
C NL NW SW

SECTION PLAT

330 Ft. from N. Line

Ft. from S. Line

Ft. from E. Line

660 Ft. from W. Line

WILDCAT

Location \_\_\_\_\_

Rig up \_\_\_\_\_

Drilling and Remarks:

Der ri ck

RECORD

Cased \_\_\_\_\_ in., \_\_\_\_\_ ft.

Sand \_\_\_\_\_

Gas \_\_\_\_\_

Oil \_\_\_\_\_

Total Depth \_\_\_\_\_

PRODUCTION

1st 24 hrs. Nat. \_\_\_\_\_

1st 24 hrs. after shot \_\_\_\_\_

Gas \_\_\_\_\_ Cu. Ft.

✓ Dry Hole \_\_\_\_\_

Abandoned \_\_\_\_\_

Date

DEC 23 1941 19S. J. LEWIS Scout

Stafford

KANSAS

Map No. 47 Sec. 29 Twp. 25 R. 11WWell No. 1 ThomasChamplin Refining CompanyABANDONED Contractor

C NL NW SW

## SECTION PLAT

330 Ft. from N. Line       Ft. from S. Line       Ft. from E. Line660 Ft. from W. Line

|   |  |  |  |
|---|--|--|--|
|   |  |  |  |
|   |  |  |  |
| 0 |  |  |  |
|   |  |  |  |

WILDCAT

Location                                 Rig up                                 

Drilling and Remarks:

*Singson 4210**Cr 4277**Nos holes*

## RECORD

Cased            in.,            ft.Sand                                 Gas                                 Oil                                 Total Depth 4288

## PRODUCTION

1st 24 hrs. Nat.                                 1st 24 hrs. after shot                                 Gas                                  Cu. Ft.Dry Hole                                 Abandoned                                 

Date

JAN 21 1942

19

S. J. LEWIS

Scout