


KANSAS

Section 5 Township 25 Range 11-WWell Number 1 J.C. RosackerCompany Stanolind

SPECIAL

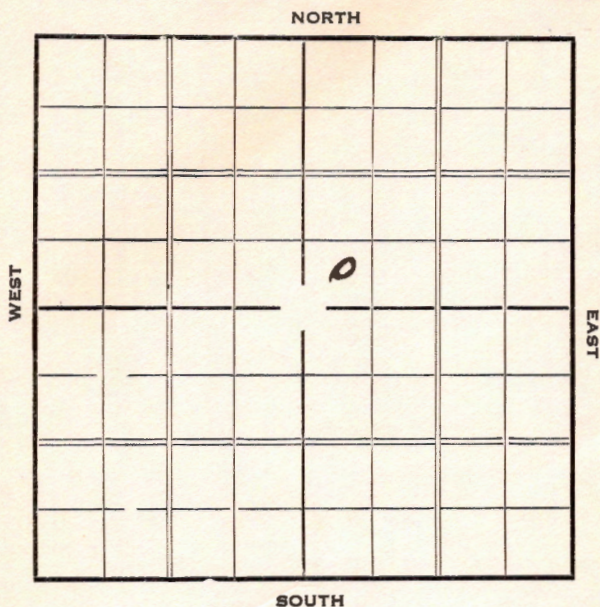

KANSAS

Stafford

Map No. Sec. 5 Twp. 25 R. 11W

Well No. 1 J.C. Rosacker Farm

Stanolind Company


..... Ft. from N. Line

330 Ft. from S. Line

..... Ft. from E. Line

330 Ft. from W. Line

Special

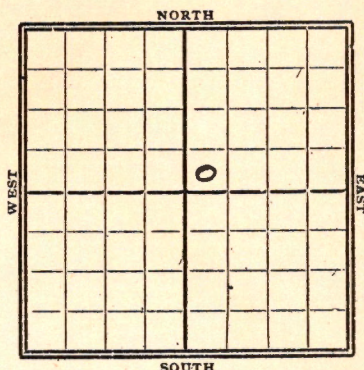Date
1936

Elev. 1804

REPORT

12/9 Rig

12/17 Rigging up

12/24 Drlg. 2029'.

12/29 Drlg. 2340'.

1937

1/7 Drlg. 3419'.

1/14 Lansing 3485'. Drlg. 3835'.

1/21 Viola 3913'. Simpson 4017'.

Drlg. 4058'.

1/27 Sil. 4110

T. D. 4147

D & A

ABANDONED

KANSAS

Map No. 47 Sec. 5 Twp. 25 R. 11W.

Well No. 1. J. C. Rosacker.

Stanford Company

Contractor

Special

SECTION PLAT

		0	

_____ Ft. from N. Line

330 Ft. from S. Line

_____ Ft. from E. Line

330 Ft. from W. Line

FIRST REPORT

Location _____

Rig up _____

Drilling and Remarks:

Rig

RECORD

Cased _____ in., _____ ft.

Sand _____

Gas _____

Oil _____

Total Depth _____

PRODUCTION

1st 24 hrs. Nat. _____

1st 24 hrs. after shot _____

Gas _____ Cu. Ft.

Dry Hole _____

Abandoned _____

Date

DEC 9 1936 19

S. J. LEWIS Scout

KANSASMap No. 47 Sec. 5 Twp. 25 R. 11WWell No. L. J. C. RosackerStarbind Company

Contractor

SECTION PLAT

		0	

 Ft. from N. Line330 Ft. from S. Line Ft. from E. Line330 Ft. from W. Line

ABANDONED

Location Rig up

Drilling and Remarks:

Sic 4110IIYA**RECORD**Cased in., ft.Sand Gas Oil Total Depth 4147**PRODUCTION**1st 24 hrs. Nat. 1st 24 hrs. after shot Gas Cu. Ft.Dry Hole Abandoned

Date

JAN 27 1937 19

S. J. LEWIS

Scout