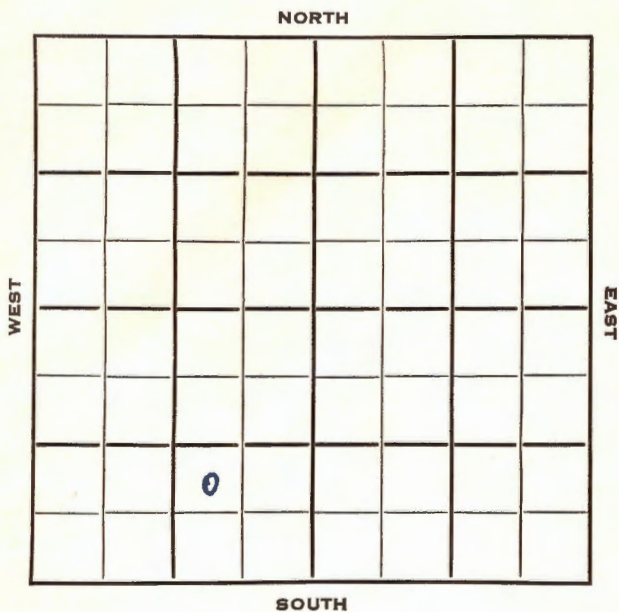


Section 17 Township 25 Range 11 WWell No. # 1 E. J. DicksonCompany Lawson Pet & Skelly Oil

Sec. 17 Twp. 25 R. 11W

Well No. #1 E.J. Dickson Farm

Lawson Pet. & Skelly Oil Company

Wildcat. Contractor

Ft. from N. Line

990


Ft. from S. Line

990

Ft. from E. Line

Ft. from W. Line

NW SE SW

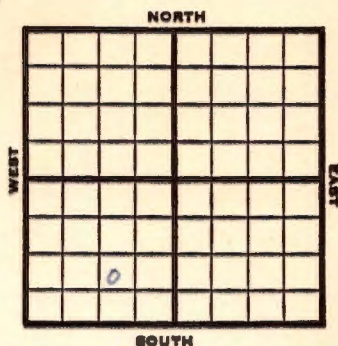

1953

Elev. 1827'

REPORT

8/5

Location

8/12

8" @ 356' w/225 sks

Heeb 3324, Br. L. 3492, Lans 3516,

DST 3558-70 1 hr, 70' Wtr, 95#

DST 3603-17 1 hr, 135' wtr, 1240#

Drlg 3674'

8/19

Spud 8-4-53

D&A

TD 4202

8" @ 356

Heeb 3324, Br lime 3492, Lans 3516

DST 3558-70, opn 1 hr., rec. 70' wtr.

95#

DST 3603-17, opn 1 hr., rec. 135'

wtr., 1240#

Miss 3846, Viola 4005

DST 4003-12, opn 1/3 hrs., rec. 5'

mud, 230#

Aimp. 4096, ReArb. 4152, Arb 4162

TD 4202

D&A

ABANDONED

County **Stafford** State **Kansas**Sec. **17** (Blk.) **25** (Sur. Rge.) **11W** Map No.Operator **Lawson Pet. & Skelly Oil**Well No. **1** Farm **E. J. Dickson**Elev. Location **NW SE SW****990** Ft. From **S** Line **SW****990** Ft. From **E** Line **Quarter**1st. Report **4/1/53** **5** 1953

Completion

Remarks

Spudding Date

Drig. Data **Wildcat**

Location

County Stafford State Kansas
 Sec. 17 (Blk. 25 (Sur. 11W Map No.
 (Twp.) (Rge.)
 Operator Lawson Pet. & Skelly Oil
 Well No. 1 Farm E. J. Dickson
 Elev. 1827 Location NW SE SW



990 Ft. From S Line SW
990 Ft. From E Line Quarter

1st. Report

Completion AUG 10 1953

Remarks Wildcat

Spudding Date 8-4-53

Drig. Data D & A TD 4202
8" @ 356 Heeb. 3324 Br. lime 3492
Lans. 3516 DST 3558-70 open 1 hr.
Rec. 70' wtr. 95# DST 3603-17
open 1 hr. Rec. 135' wtr. 1240#
Miss. 3846 Viola 4005 DST 4003-12
open 1/3 hr. Rec. 5' mud 230#
Simp. 4096 ReArb. 4152 Arb. 4162
TD 4202

D & A