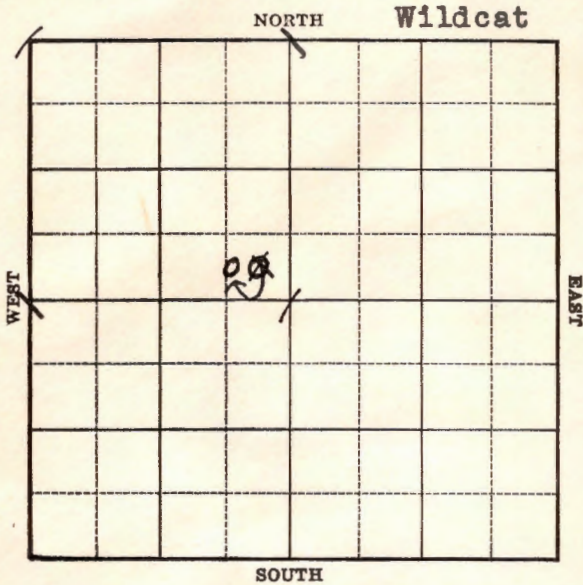


Form 51—5M—11-38—Palace

Section 21 Township 25 Range 11-WWell No. 1 SecrestCompany E. H. Moore

Stafford

KANSAS

Map No. 47 Sec. 21 Twp. 25 R. 11WWell No. 1 SecrestE. H. Moore

Company

Contractor

FIRST REPORT


Vickers F.O.
SECTION PLAT

SE NW

Ft. from N. Line

330 Ft. from S. Line330 Ft. from E. Line

Ft. from W. Line

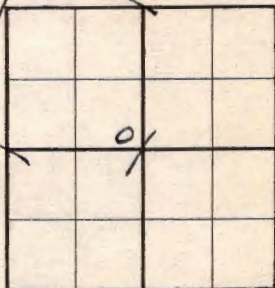

WILDCAT

Location _____

Rig up _____

Drilling and Remarks:

RUR

RECORD

Cased _____ in., _____ ft.

Sand _____

Gas _____

Oil _____

Total Depth _____

PRODUCTION

1st 24 hrs. Nat. _____

1st 24 hrs. after shot _____

Gas _____ Cu. Ft.

Dry Hole _____

Abandoned _____

Date

MAR 22 1939

19

H. D. Hatfield

Scout

STAFFORD KANSAS

Map No. 47 Sec. 21 Twp. 25 R. 11 ^WWell No. 1 - SecrestE. H. Moore Company

Contractor

CSLSE NW

SECTION PLAT

CORRECTION

 Ft. from N. Line330 Ft. from S. Line650 Ft. from E. Line Ft. from W. Line

CORRECTION

	50		

Location Rig up

Drilling and Remarks:

Location corrected
From SENW To
CSLSE NW

RECORD

Cased in., ft.Sand Gas Oil Total Depth

PRODUCTION

1st 24 hrs. Nat. 1st 24 hrs. after shot Gas Cu. Ft.Dry Hole Abandoned

Date

MAR 29 1939

19

H. D. Hatfield

Scout

Map No. 47 Sec. 21 Twp. 25 R. 11WWell No. 1 SecretE. H. Moore

Company

Contractor

ABANDONED

C S L SE NW

 Ft. from N. Line330 Ft. from S. Line650 Ft. from E. Line Ft. from W. Line

SECTION PLAT

	0		

WILDCAT

Location Rig up

Drilling and Remarks:

Viola 3987
Simp. Sh. 4080
Simp. sd. 4110
Arb 4157
T.D. 4165
Sulphur odor No oil
D & A

RECORD

Cased in., ft.Sand Gas Oil Total Depth

PRODUCTION

1st 24 hrs. Nat. 1st 24 hrs. after shot Gas Cu. Ft.Dry Hole Abandoned

Date

APR 19 1939

19

H. D. Hatfield Scout