

FORM 51

Section 7 Township 25 Range 11W

Well No. #1 Newell

Company N.C.R.A.

NORTH

0							

WEST

EAST

SOUTH

HOT FILE

Stafford

KANSAS ✓

SEC.	TWP.	R.
7	25	11 W


WELL NO. # 1 Newell FARM

COMPANY NCRA

CONTRACTOR B & B Drlg.

Wildcat

_____ Ft. from N. Line
 990 _____ Ft. from S. Line
 _____ Ft. from E. Line
 330 _____ Ft. from W. Line

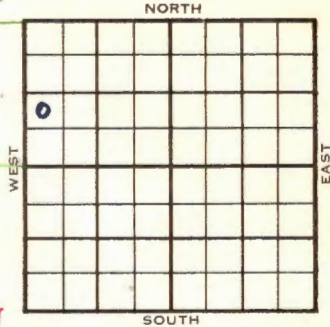

NW SW NW
 MCPC has NE of 11-25-12W

	ELEVATION	REPORT
1953	1823'	
9/30	Spud 9-26-53 8" @ 263 Drlg. 2025'	
10/7	Anhy 604, Heeb 3301, Lans 3489. DST 3534-67' 2 hrs, 125' Hly o & gcm, 200' Hlygco, 40' wtr, 103# DST 3573'-3623' 2 hrs, 420' SW, 1282# Drlg 3670'	
10/15	Conglomerate 3846' Kinderhook 3857' Viola 3913' DST 3914-22, 2 hrs, 3540' clean oil, BHP 1205# Simpson 4056' DST 4052-96', open 2 hrs, 140' SW BHP 1340# Arbuckle 4127' RTD 4136' Schl 5½" @ 4130 (Tel-McGeh)	
10/22	CO to 4130½', FU 2400' SW 3 hrs. PB 3950' 20/3912-16 B/5 GOFH 2 hr. 55 A No help. 250 A F/63 BO 3/4 hr. (Ltr-McGehee)	
10/29	Waiting on state test. " "	
11/11	N.R.	
11/19	Completed for 3000 BOPD " "	

OVER

1953
11/18

Spud 9-26-53 Oil well TD 4136
8" @ 263 **Anhy 604 Heeb 3301**
Lans 3489'

DST 3534-67 open 2 hr rec 125' HG
& OCM, 200' HGCO, 40' wtr. 1039#

DST 3573-3623, open 2 hr, rec 420' SW
1282# **Cong. 3846' Kh. 3857**

Viola 3913'

DST 3914-22, open 2 hr rec 3540' oil
1205# **Simp. 4056'**

DST 4052-96 open 2 hr rec 140' SW

1340# **Arb. 4127** TD 4136 5" @ 4136

CO to 4130 FU 2400' SW 3 hr.

PB 3950 20/3912-16 B/5 GOPH 2 hr

55 A 250 A F/63 BO 3/4 hr.

Comp. 3000 BOPD

COMPLETED

County **Stafford** State **Kansas**

Sec. **7** (Blk. Twp.) **25** (Sur. Rge.) **11W** Map No.

Operator **N C R A**

Well No. **1** Farm **Nowell**

Elev. Location **NW SW NW**

990 Ft. From **S** Line **NW**

330 Ft. From **W** Line Quarter

1st. Report SEP 30 1952

Completion

Remarks **MCPC has NE of**

B & B Drlg. - Contr.

Spudding Date **9-26-53**

Drlg. Data **Wildcat**

8" @ 263 drlg. 2025

County Stafford State KansasSec. 7 (Blk.
Twp.) 25 (Sur.
Rge.) 11W Map No.Operator N C R AWell No. 1 Farm NewellElev. 1823 Location NW SW NW

0					

990 Ft. From S Line NW330 Ft. From W Line Quarter

1st. Report

NOV 18 1953

Completion

Remarks WildcatB & B Drlg. - Contr.Spudding Date 9-26-53Drlg. Data Oil well TD 41368" @ 263 Anhy 604 Heeb. 3301Lans. 3489 DST 3534-67 open 2 hr.Rec. 125' hg & ocm 200' hgco 40' wtr.1039# DST 3573-3623 open 2 hr. Rec.420' sw 1282# Cong. 3846 Kh. 3857Viola 3913 DST 3914-22 open 2 hr.Rec. 3540' oil 1205# Simp. 4056DST 4052-96 open 2 hr. Rec. 140' sw1340# Arb. 4127 TD 4136 5" @ 4130CO to 4130 FU 2400' sw 3 hr. PB 395020/ 3912-16 B/ 5 goph 2 hr. 55 A250 A F/ 63 bo 3/4 hr.Comp. 3000 bopd

J. G. McGEHEE