


Section 7 Township 25 Range 11W

Well No. 2 Newell

Company NCRA

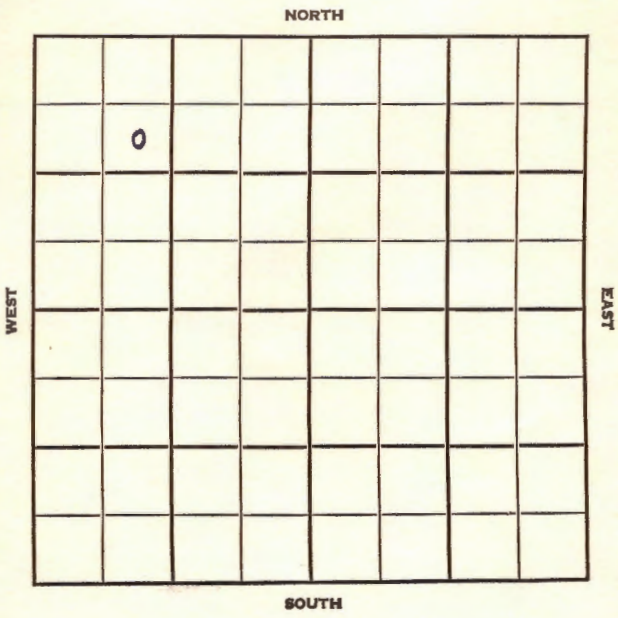

SEC.	TWP.	R.
7	25	11W ✓

WELL NO. #2 Newell FARM

COMPANY N C R A

CONTRACTOR Rocket Drlg.

Hicky Pool

990	Ft. from N. Line	
	Ft. from S. Line	
	Ft. from E. Line	
990	Ft. from W. Line	

SE NW NW

	ELEVATION	REPORT
1954	1824	
4/27	M I R	
5/5	8" @ 265' w/175 sks	
	Anhy 601'	
	Drlg 3135'	
5/12	Heeb 3301', Br. L. 3459', Lans 3488	
	DST 3533'-54' 2 hrs, 100' O&GCM,	
	80' ocm, 60' mco, 20' o & gcm, 10'	
	wcm 1410#	
	DST 3558'-69' 2hrs, 1170' gas, 5'	
	mco, 45' oily mud, 45' wtr.	
12/7	Spudding 4-27-54	
	Oil well	
	TD 3937	
	8" @ 265	
	Anhy 601 Heeb 3301 Br. line 3459	
	Lans. 3488	
	DST 3533-54 open 2 hr. Rec. 100' o &	
	gcm 80' ocm 60' mco 20' ho & gcm 10'	
	wcm 1410#	
	DST 3558-69 open 2 hr. Rec. 1170' gas	
	5' mco 45' oily mud 45' wtr. 1140#	
	DST 3571-90 open 2 hr. Rec. 200' sw	
	1180#	
	Cong. 3831 Miss. 3835 Kh. 3873.	
	Viola 3926	

1954

12/7 TD 3928

5" @ 3925

DD 3932 250 A DD 3935 3 go 110 gw
4 hr. DD 3937 2½ go 47½ gw 1 hr.
500 A PB 3579 6/ 3537-38 2 go 18 gw
4 hr. 12/ 3538-40 6½ gf 1 hr. 250 A
S/ 2½ bf 1 hr. S/ 13½ bf 50% oil
10 hr. 1000 A F/ 5 bfph F/ 6½ mbf
2 hr. 50% wtr. F/ 18 bo Comp. 25
bopd 21% wtr.

COMPL.---

Drlg. Data

S/ $13\frac{1}{2}$ bf 50% oil 10 hr. 1000A

F/ 5 bfph F/ $6\frac{1}{2}$ bf 2 hr. 50% wtr.

F/ 18 bo Comp. 25 bopd 21% wtr.

Scout Cards
Land Small Map
Land Wall Map
Tracings
France Map
Pierce Map
Misc.

DM

JUL 12 1953