



Stafford

Map No. KANSAS Sec. 15 Twp. 25 R. 1140


Well No. 1 Craven Farm  
Trubers & Phillips Company

\_\_\_\_\_ Ft. from N. Line

330' Ft. from S. Line

\_\_\_\_\_ Ft. from E. Line

330' Ft. from W. Line

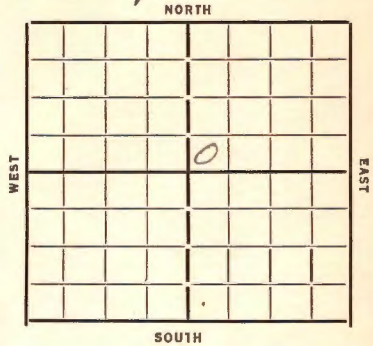

Date 1933

REPORT

OWDD

<u>12/6</u>	<u>B.R.</u>		
<u>12/13</u>	<u>Regm up</u>		
<u>12/27</u>	<u>Drly 330</u>		<u>20" at 180</u>
<u>1/4</u>	<u>15" at 548</u>		
<u>1/11</u>	<u>Drly 1400</u>		
<u>1/17</u>	<u>S.D. 1820</u>		
<u>1/24</u>	<u>Drly 2220</u>		<u>12" at 1645</u>
<u>1/31</u>	<u>" 2335</u>		<u>10" at 2315</u>
<u>2/7</u>	<u>" 2635</u>		
<u>2/14</u>	<u>" 2900</u>		<u>10" at 2629</u>
<u>2/23</u>	<u>3000 N47W</u>	<u>8" 3048</u>	<u>TD 3083<sup>U.R.</sup></u>
<u>3/1</u>	<u>N47W 3165</u>	<u>show oil</u>	<u>3225</u>
	<u>U R 8"</u>		
<u>3/8</u>	<u>Drly 3425</u>	<u>8" 3278</u>	<u>N47W 3375</u>
<u>3/15</u>	<u>" 3610</u>	<u>8" 3445</u>	<u>U @ 3463</u>
	<u>S.O. 3545-60</u>		
<u>3/22</u>	<u>8" 3835</u>	<u>@ 0</u>	
<u>3/26</u>	<u>Top line 3921</u>	<u>Hole full oil</u>	
<u>3/29</u>	<u>6" 3841</u>	<u>Viola 3920</u>	<u>TD 3921</u>
	<u>400' oil 30 Min 40</u>	<u>Gas.</u>	
	<u>1/2 M Gas</u>	<u>Flow every 14 hrs.</u>	
<u>4/5</u>	<u>Subing to test</u>		

4/12 3921 Pumped 151 oil 20  
water 24 hrs. Deepened  
3922 flow 8 Bbls per hr  
Will deepen

4/19 TD 3924 Pump 304 oil  
39 fl. 24 hrs.

4/26 Mill acidize

5/3 —

5/9 Viola 3920 TD 3924  
180 oil 277 water

### COMPLETED

1934

OWDD

6/20 OTD 3924

Pulling tubing to deepen

6/28 —

7/5 Simpson 4025 SD 4085

7/12 Siliceous 4049 Aly 4103

7/18 Siliceous 4049  
TD 4103 2/7 fl D + A

### ABANDONED

Map No. 47 Sec. 15 Twp. 25 R. 11W

Well No. 1-Crowns

Vickers & Phillips Company

Contractor

**FIRST REPORTS**

**SECTION PLAT**

		0	

..... Ft. from N. Line

330 Ft. from S. Line

..... Ft. from E. Line

330 Ft. from W. Line

Location.....

Rig up.....

Drilling and Remarks:

B.R.

**RECORD**

Cased..... in., ..... ft.

Sand.....

Gas.....

Oil.....

Total Depth.....

**PRODUCTION**

1st 24 hrs. Nat.....

1st 24 hrs. after shot.....

Gas..... Cu. Ft.

Dry Hole.....

Abandoned.....

Date

12-6-33 192 O. W. Mannick Scout

Map No. 47 Sec. 15 Twp. 25 R. 11W

Well No. 1 - Cravens

Vickers & Phillips Company  
Contractor

**COMPLETED**

**SECTION PLAT**

		0	

\_\_\_\_\_ Ft. from N. Line

330 Ft. from S. Line

\_\_\_\_\_ Ft. from E. Line

330 Ft. from W. Line

Location \_\_\_\_\_

Rig up \_\_\_\_\_

Drilling and Remarks:

180 oil  
277 water

**RECORD**

Cased \_\_\_\_\_ in., \_\_\_\_\_ ft.

Sand Viola 3920

Gas \_\_\_\_\_

Oil \_\_\_\_\_

Total Depth 3924

**PRODUCTION**

1st 24 hrs. Nat. \_\_\_\_\_

1st 24 hrs. after shot \_\_\_\_\_

Gas \_\_\_\_\_ Cu. Ft.

Dry Hole \_\_\_\_\_

Abandoned \_\_\_\_\_

Date

5-9-34 19

**ORVAL MANNSCHECK**

Scout

Map No. 47 Sec. 15 Twp. 25 R. 11W

Well No. 1- Cravens

Vickers & Phillips Company

Contractor

**FIRST REPORT SECTION PLAT**

Ft. from N. Line

330 Ft. from S. Line

Ft. from E. Line

330 Ft. from W. Line

CWSD

		0	

Location \_\_\_\_\_

Rig up \_\_\_\_\_

Drilling and Remarks:

OTU 3924

pulling tubing to deepen

**RECORD**

Cased \_\_\_\_\_ in., \_\_\_\_\_ ft.

Sand \_\_\_\_\_

Gas \_\_\_\_\_

Oil \_\_\_\_\_

Total Depth \_\_\_\_\_

**PRODUCTION**

1st 24 hrs. Nat. \_\_\_\_\_

1st 24 hrs. after shot \_\_\_\_\_

Gas \_\_\_\_\_ Cu. Ft.

Dry Hole \_\_\_\_\_

Abandoned \_\_\_\_\_

Date

6-20-34 19

**ORVAL MANNSCHRECK**

Scout

Map No. 47 Sec. 15 Twp. 25 R. 11W

Well No. 1-Cravens

Vickers pet

Company

Contractor

OWPD

SECTION PLAT

		0	

\_\_\_\_\_ Ft. from N. Line

330 Ft. from S. Line

\_\_\_\_\_ Ft. from E. Line

330 Ft. from W. Line

**ABANDONED**

Location \_\_\_\_\_

Rig up \_\_\_\_\_

Drilling and Remarks:

HFW  
10+H

RECORD

Cased \_\_\_\_\_ in., \_\_\_\_\_ ft.

Sand silicious 4049

Gas \_\_\_\_\_

Oil \_\_\_\_\_

Total Depth 4103

PRODUCTION

1st 24 hrs. Nat. \_\_\_\_\_

1st 24 hrs. after shot \_\_\_\_\_

Gas \_\_\_\_\_ Cu. Ft.

Dry Hole \_\_\_\_\_

Abandoned \_\_\_\_\_

Date

7-18-34 19 \_\_\_\_\_

**ORVAL MANNSCHECK**

Scout