

Section 15 Township 25 Range 11W

Well No. #2-Tarrant

Company Derby Oil et al

NORTH

WEST

EAST

		0					

SOUTH



Sec. **15** Twp. **25** R. **11 W**

Well No. **# 2 Tarrant** Farm

**Derby Oil et al** Company

**Mallard** Contractor  
**Neola**


Ft. from N. Line

**330** Ft. from S. Line

**990** Ft. from E. Line

Ft. from W. Line

**SW SE SW**

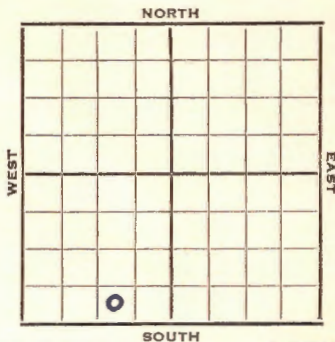

1952

**Elev. 1829'** REPORT

9/17

Location

9/24

8" @280 Drlg. 3210'

10/1

**Heeb 3287 Br Li 3458**

**Lans 3479**

DST 3506-35, 1 hr. 150' SW 1040#

**V 3946**

DST 3946-50, 1/2 hr. 10' OCM 105#

DST 3947-53, 1 hr. 120' hvy O&GCM

3700' gas 525# RTD 3953

5" @ 3949'

10/8

CO to 3953'

S/ 1 1/2 boph 1500 A S/ 32 BW 1 hr.

10/15

POP

10/22

P/15 BOPD

10/29

P/12 1/2 BO & 312 BWPD

11/5

NR

11/12

"

11/20

"

11/26

Spud 9-16-52

Oil Well

TD 3953'

8" @ 280'

**Heeb 3287', Br lime 3458', Lans 3479'**

**OVER**

1952 (Information Brought Forward)  
11/26 DST 3506-35, opn 1 hr., rec. 150'  
SW 1040#  
**Viola 3946'**  
DST 3946-50, opn  $\frac{1}{2}$  hr., rec. 10'  
ocm 105#  
DST 3947-53, opn 1 hr., rec. 120'  
ho & gcm 3700' gas 525#  
TD 3953  
5" @ 3949  
CO to 3953  
S/ $1\frac{1}{2}$  boph 1500A S/32 bw 1 hr.,  
P/ $12\frac{1}{2}$  bopd 312 bw  
Comp.  $7\frac{1}{2}$  bopd 376 bw

**COMPLETED**



