

KANSAS

Stafford


Section 15 Township 25 Range 11WWell No. 1 SanfordCompany Derby Oil & Kowa

Neola

NORTH

WEST

EAST

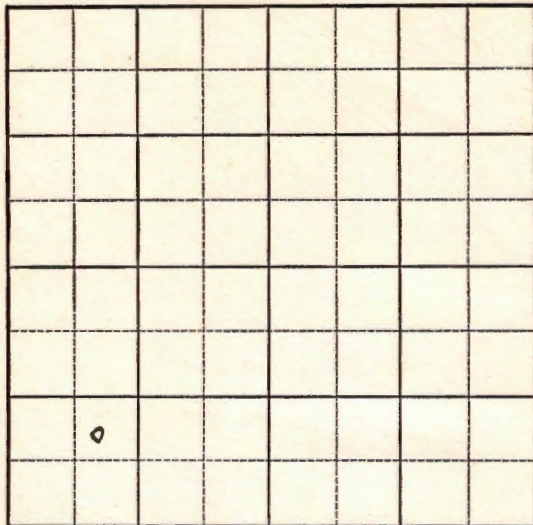

SOUTH

KANSAS

Stafford

Sec. 15 Twp. 25 R. 11W ✓

Well No. #1 Sanford Farm

Derby Oil & Kiowa

Company

Neola Pool

 Ft. from N. Line

990'


 Ft. from S. Line

 Ft. from E. Line

990'

 Ft. from W. Line

NE SW SW

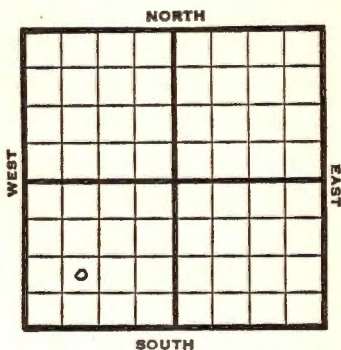

1949

Elev. 1811'

REPORT

2/23

Location

3/2

RUR

3/8

"

3/16

8" @ 285'

Drlg. 2075'

3/23

Drlg 3415'

3/30

Lans 3438'

BKC 3804'

Kind 3844'

Viola 3946'

TD 3949'

ABANDONED

Map No. _____ Sec. 15 Twp. 25 R. 11W

Well No. 1 Sanford

Derby Oil & Kiowa Company

FIRST REPORT

Contractor _____

NE SW SW


SECTION PLAT

_____ Ft. from N. Line

990 Ft. from S. Line

_____ Ft. from E. Line

990 Ft. from W. Line

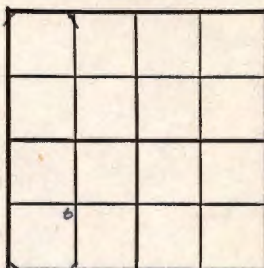

Stafford County

Location X

Rig up _____

Drilling and Remarks:

RECORD

Cased _____ in., _____ ft.

Sand _____

Gas _____

Oil _____

Total Depth _____

PRODUCTION

1st 24 hrs. Nat. _____

1st 24 hrs. after shot _____

Gas _____ Cu. Ft.

Dry Hole _____

Abandoned _____

Date

FEB 23 1949 19

S. J. LEWIS Scout

Kansas

Map No. 47 Sec. 15 Twp. 25 R. 11WWell No. 1 SanfordDerby Oil & Kiowa Company**ABANDONED**

Contractor

NE SW SW

E 11 1/4
SECTION PLAT

 Ft. from N. Line990 Ft. from S. Line Ft. from E. Line990 Ft. from W. LineStafford CountyLocation Rig up

Drilling and Remarks:


Date

MAR 30 1949

19

S. J. LEWIS

Scout