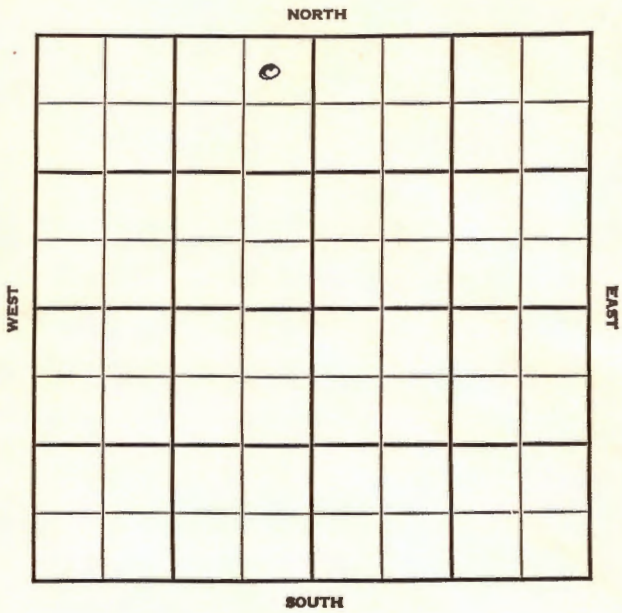


KANSAS

Section 18 Township 25 Range 11WWell No. #1 WatsonCompany Nu Enamel

KANSAS

Stafford

✓

Sec. 18 Twp. 25 R. 11W

Well No. #1 Watson Farm


Nu Enamel Company
Wildcat

330 Ft. from N. Line

 Ft. from S. Line

330 Ft. from E. Line

 Ft. from W. Line

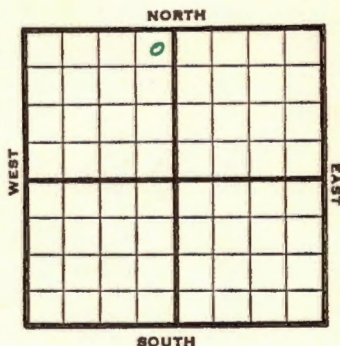

NE NW

1947 **Elev. 1810'** REPORT

11/19 8" @ 59'
Drlg. 788'

11/25 **Lansing 3483'**
Drlg. 3668'

12/3 **Viola 3968'**
Simp Sd 4088'
Arbuckle 4134'
Total Depth 4200'

ABANDONED

Map No. _____ Sec. 18 Twp. 25 R. 11W

Well No. 1 Watson


Nu Enamel _____ Company

FIRST REPORT

Contractor _____

NE NW

SECTION PLAT

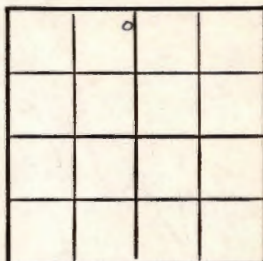

330 Ft. from N. Line

_____ Ft. from S. Line

330 Ft. from E. Line

_____ Ft. from W. Line

Stafford County

Location _____

Rig up _____

Drilling and Remarks:

8" @ 459

drlg. 788

RECORD

Cased _____ in., _____ ft.

Sand _____

Gas _____

Oil _____

Total Depth _____

PRODUCTION

1st 24 hrs. Nat. _____

1st 24 hrs. after shot _____

Gas _____ Cu. Ft.

Dry Hole _____

Abandoned _____

Date

NOV 1 9 1947

19

S. J. LEWIS

Scout

Map No. 47 Sec. 18 Twp. 25 R. 11W

Well No. 1 Watson

Nu Enamel Company

ABANDONED

Contractor

NE NW

E. 1518
SECTION PLAT

330 Ft. from N. Line

 Ft. from S. Line

330 Ft. from E. Line

 Ft. from W. Line

	6		

Stafford County

Location

Rig up

Drilling and Remarks:

10128965
Single Col 4055
Art 4137

RECORD

Cased in., ft.

Sand

Gas

Oil

Total Depth 4200

PRODUCTION

1st 24 hrs. Nat.

1st 24 hrs. after shot

Gas Cu. Ft.

Dry Hole

Abandoned

Date

DEC 3 1947

19

S. J. LEWIS

Scout