

KANSAS


Stafford

FORM 51 5M 4-41 PETROL

Section 7 Township 25 Range 12W

Well No. 1-Mather

Company F. C. Hall

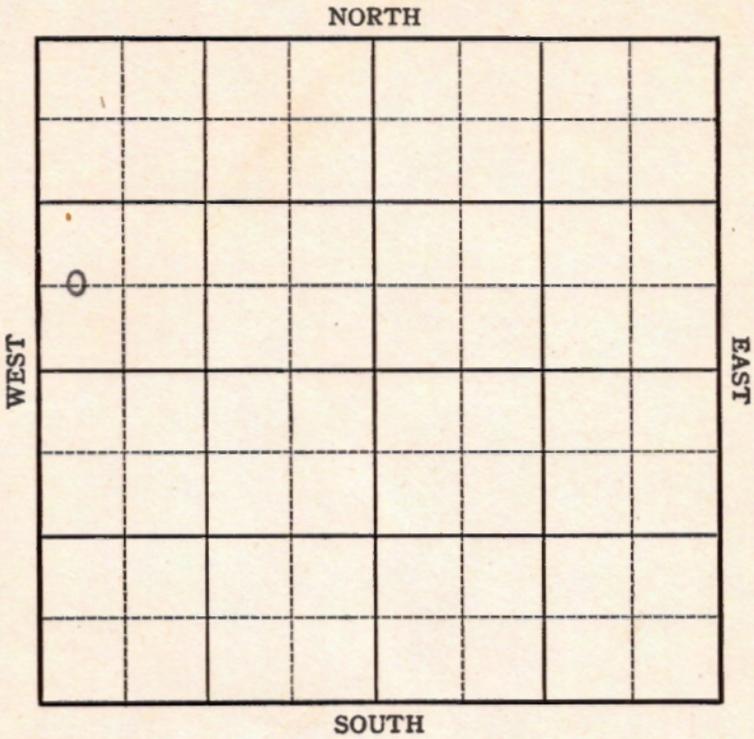

Sec. 7 Twp. 25 R. 12-W

Well No. #1 Mather Farm

F. C. Hall Company


(Semi-Wildcat)

\_\_\_\_\_ Ft. from N. Line

660 Ft. from S. Line

\_\_\_\_\_ Ft. from E. Line

330 Ft. from W. Line

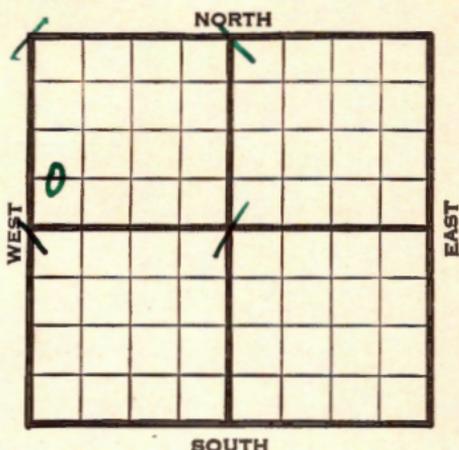

**Elev. 1911**

REPORT

<del>1941</del>	
9/3	Derrick.
9/11	"
9/18	10" - 440' <b>Anhy 738'</b>
	Drlg. 1160'
9/25	Drlg. 2930'
10/2	Lans. 3590' <b>Drlg. 3660'</b> S.S.O.
10/9	Kind. 3945' <b>Viola 4121'</b>
	Drlg. 4145'
10/15	<b>Arb. 4161'</b>
	T.D. 4173'
	Water.

**ABANDONED**

Map No. 47 Sec. 7 Twp. 25 R. 12W

Well No. 1 Mather

F. C. Hall Company

**FIRST REPORT** Contractor

C W L SW NW


\_\_\_\_\_ Ft. from N. Line

660 Ft. from S. Line

\_\_\_\_\_ Ft. from E. Line

330 Ft. from W. Line

**SECTION PLAT**

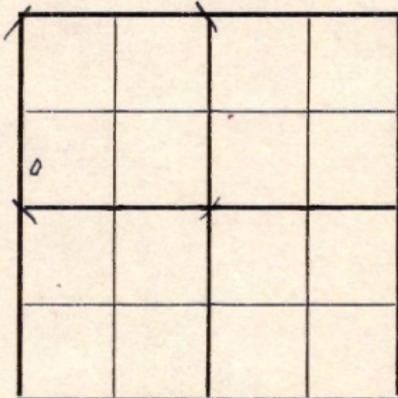

**SEMI-WILDCAT**

Location \_\_\_\_\_

Rig up \_\_\_\_\_

Drilling and Remarks:

**Derrick**

**RECORD**

Cased \_\_\_\_\_ in., \_\_\_\_\_ ft.

Sand \_\_\_\_\_

Gas \_\_\_\_\_

Oil \_\_\_\_\_

Total Depth \_\_\_\_\_

**PRODUCTION**

1st 24 hrs. Nat. \_\_\_\_\_

1st 24 hrs. after shot \_\_\_\_\_

Gas \_\_\_\_\_ Cu. Ft.

Dry Hole \_\_\_\_\_

Abandoned \_\_\_\_\_

Date

SEP 3 1941 19

**S. J. LEWIS** Scout

Map No. H-47 Sec. 7 Twp. 25 R. 12W

Well No. 1 Mather

F. C. Hall Company

ABANDONED Contractor

C W L SW NW

SECTION PLAT

         Ft. from N. Line

660 Ft. from S. Line

         Ft. from E. Line

330 Ft. from W. Line

0			

SEMI-WILDCAT

Location                                 

Rig up                                 

Drilling and Remarks:

*On #4161  
Water*

RECORD

Cased          in.,          ft.

Sand                                 

Gas                                 

Oil                                 

Total Depth 4173

PRODUCTION

1st 24 hrs. Nat.                         

1st 24 hrs. after shot                 

Gas                                  Cu. Ft.

Dry Hole                                 

Abandoned                                 

Date

OCT 15 1941

19

S. J. LEWIS Scout