

KANSAS

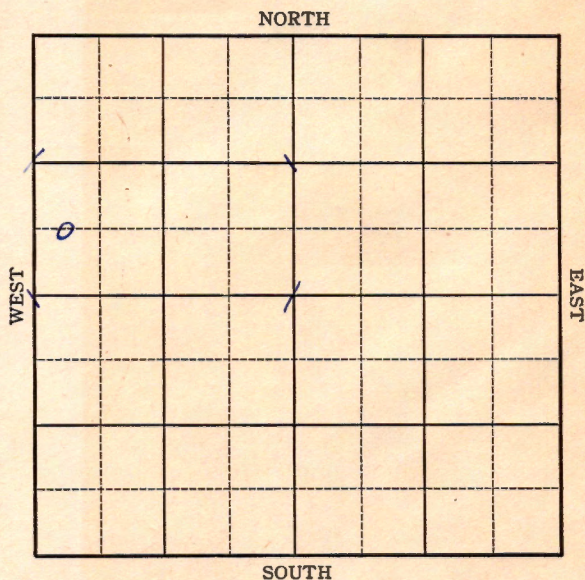
FORM 51 5M 1-42 PETROL

Stafford

Section 2 Township 25 Range 12-W

Well No. #1 Jenkins

Company ~~Marilyn Oil~~ Falcon-Seaboard et al



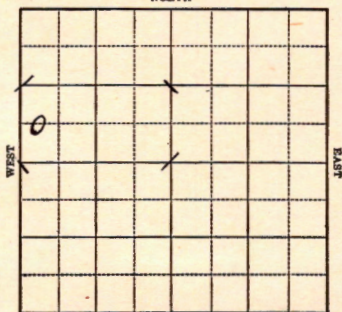
KANSAS

Stafford

Sec. 2 Twp. 25 R. 12-W

Well No. #1 Jenkins Farm
Falcon-Seaboard etal
Marlyn Oil Company

NORTH



SOUTH

 Ft. from N. Line

660 Ft. from S. Line

 Ft. from E. Line

330 Ft. from W. Line

1943

R E P O R T

9/29 Derrick
10/6 Drlg. 590'
10/13 **Anhy 652**
8" @ 660'
Drlg. 2850'
10/20 **Lans 3540**
BKC 3810
T.D. 3902
Lost Circulation
10/27 **Viola 3978**
Arb 4072
T.D. 4175'

ABANDONED

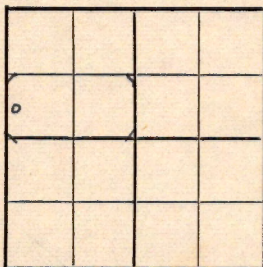
KANSAS
Map No. 47 Sec. 2 Twp. 25 R. 12WWell No. 1 JenkinsMerlyn Oil Company

FIRST REPORT

Contractor

C W I SW NW

SECTION PLAT

 Ft. from N. Line660 Ft. from S. Line Ft. from E. Line330 Ft. from W. Line

Wildcat

Location Rig up

Drilling and Remarks:

Derrick

RECORD

Cased in., ft.Sand Gas Oil Total Depth

PRODUCTION

1st 24 hrs. Nat. 1st 24 hrs. after shot Gas Cu. Ft.Dry Hole Abandoned

Date

SEP 29 1943 19

S. J. LEWIS Scout

KANSAS
Map No. 47 Sec. 2 Twp. 25 R. 12WWell No. 1 JenkinsFalcon-Seaboard etal.

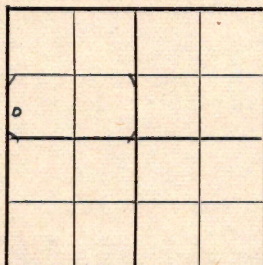
Company

CORRECTION

Contractor

C W L SW NW

SECTION PLAT

 Ft. from N. Line660 Ft. from S. Line Ft. from E. Line330 Ft. from W. LineWildcatLocation Rig up

Drilling and Remarks:

Reported
Marlyn Oil

RECORD

Cased in., ft.Sand Gas Oil Total Depth

PRODUCTION

1st 24 hrs. Nat. 1st 24 hrs. after shot Gas Cu. Ft.Dry Hole Abandoned

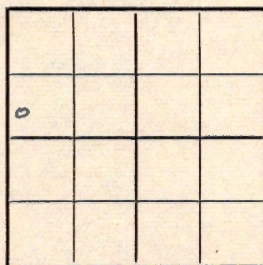
Date

OCT 6 1943 19S. J. LEWIS Scout

KANSAS
 Map No. 47 Sec. 2 Twp. 25 R. 12W

Well No. 1 JenkinsFalcon Seaboard et al. Company**ABANDONED**

Contractor

C W L SW NW**SECTION PLAT** Ft. from N. Line660 Ft. from S. Line Ft. from E. Line330 Ft. from W. LineWildcatLocation Rig up

Drilling and Remarks:

Viva 8978.Ar 4072**RECORD**Cased in., ft.Sand Gas Oil Total Depth 4125**PRODUCTION**1st 24 hrs. Nat. 1st 24 hrs. after shot Gas Cu. Ft.Dry Hole Abandoned

Date

OCT 27 194319S. J. LEWISScout