


Stafford KANSAS

DX 78-1

Section 4 Township 25 Range 12W
 Well No. 1 McCune
 Company Glickman Oil

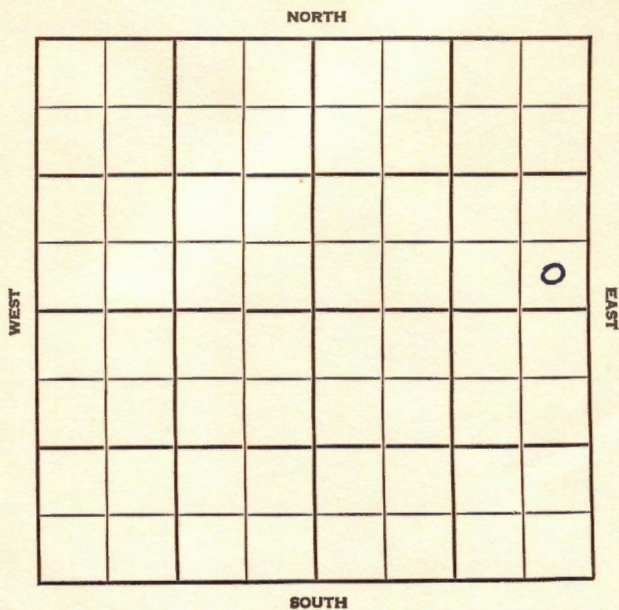

Stafford KANSAS

SEC.	TWP.	R.
4	25	12W

WELL NO.

1 McCune

COMPANY

Glickman Oil

FARM

CONTRACTOR


Schager
Wildcat

Ft. from N. Line

330 Ft. from S. Line

330 Ft. from E. Line

Ft. from W. Line

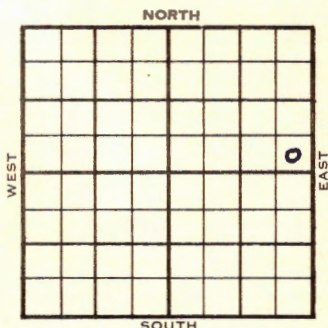

SE SE NE

Sunray Hartman & Deep Rock-DHM

	ELEVATION	REPORT
1954	1882	
7/21	Spdg 7-15-54 8" @ 255 Drlg. 2978	
8/4	Spdg 7-15-54 D&A TD 4170 8" @ 255 Heeb 3377 Tor 3394 Br. Lime 3533 Lans. 3557 DST 3560-3600 open 1 hr. Rec. 110' soc socm 0# DST 3692-3720 open 1 hr. Rec. 30' socm 0# BKC 3832 Marm 3861 Cong. 3900 Viola 3965 DST 3968-4050 open 1 hr. Rec. 150' gas 35' mud 225# Simp. 4080 DST 4077-4113 open 1 hr. Rec. 248' socsw 434' sw 1315# Arb. 4146 TD 4170 D&A	

ABANDONED

County **Stafford** State **Kansas**Sec. **4** (Blk.) **25** (Sur.) **12W** Map No.Operator **Glickman Oil**Well No. **1** Farm **McCune**Elev. Location **SE SE NE**

FIRST REPORT

330 Ft. From **S** Line **NE****330** Ft. From **E** Line Quarter1st. Report **JUL 21 1954**

Completion

Remarks **Sunray, Hartman & Deep Rock - DHM****Schafer - Contr.**Spudding Date **7-15-54**Drlg. Data **Wildcat****8" @ 255 drlg. 2978**